


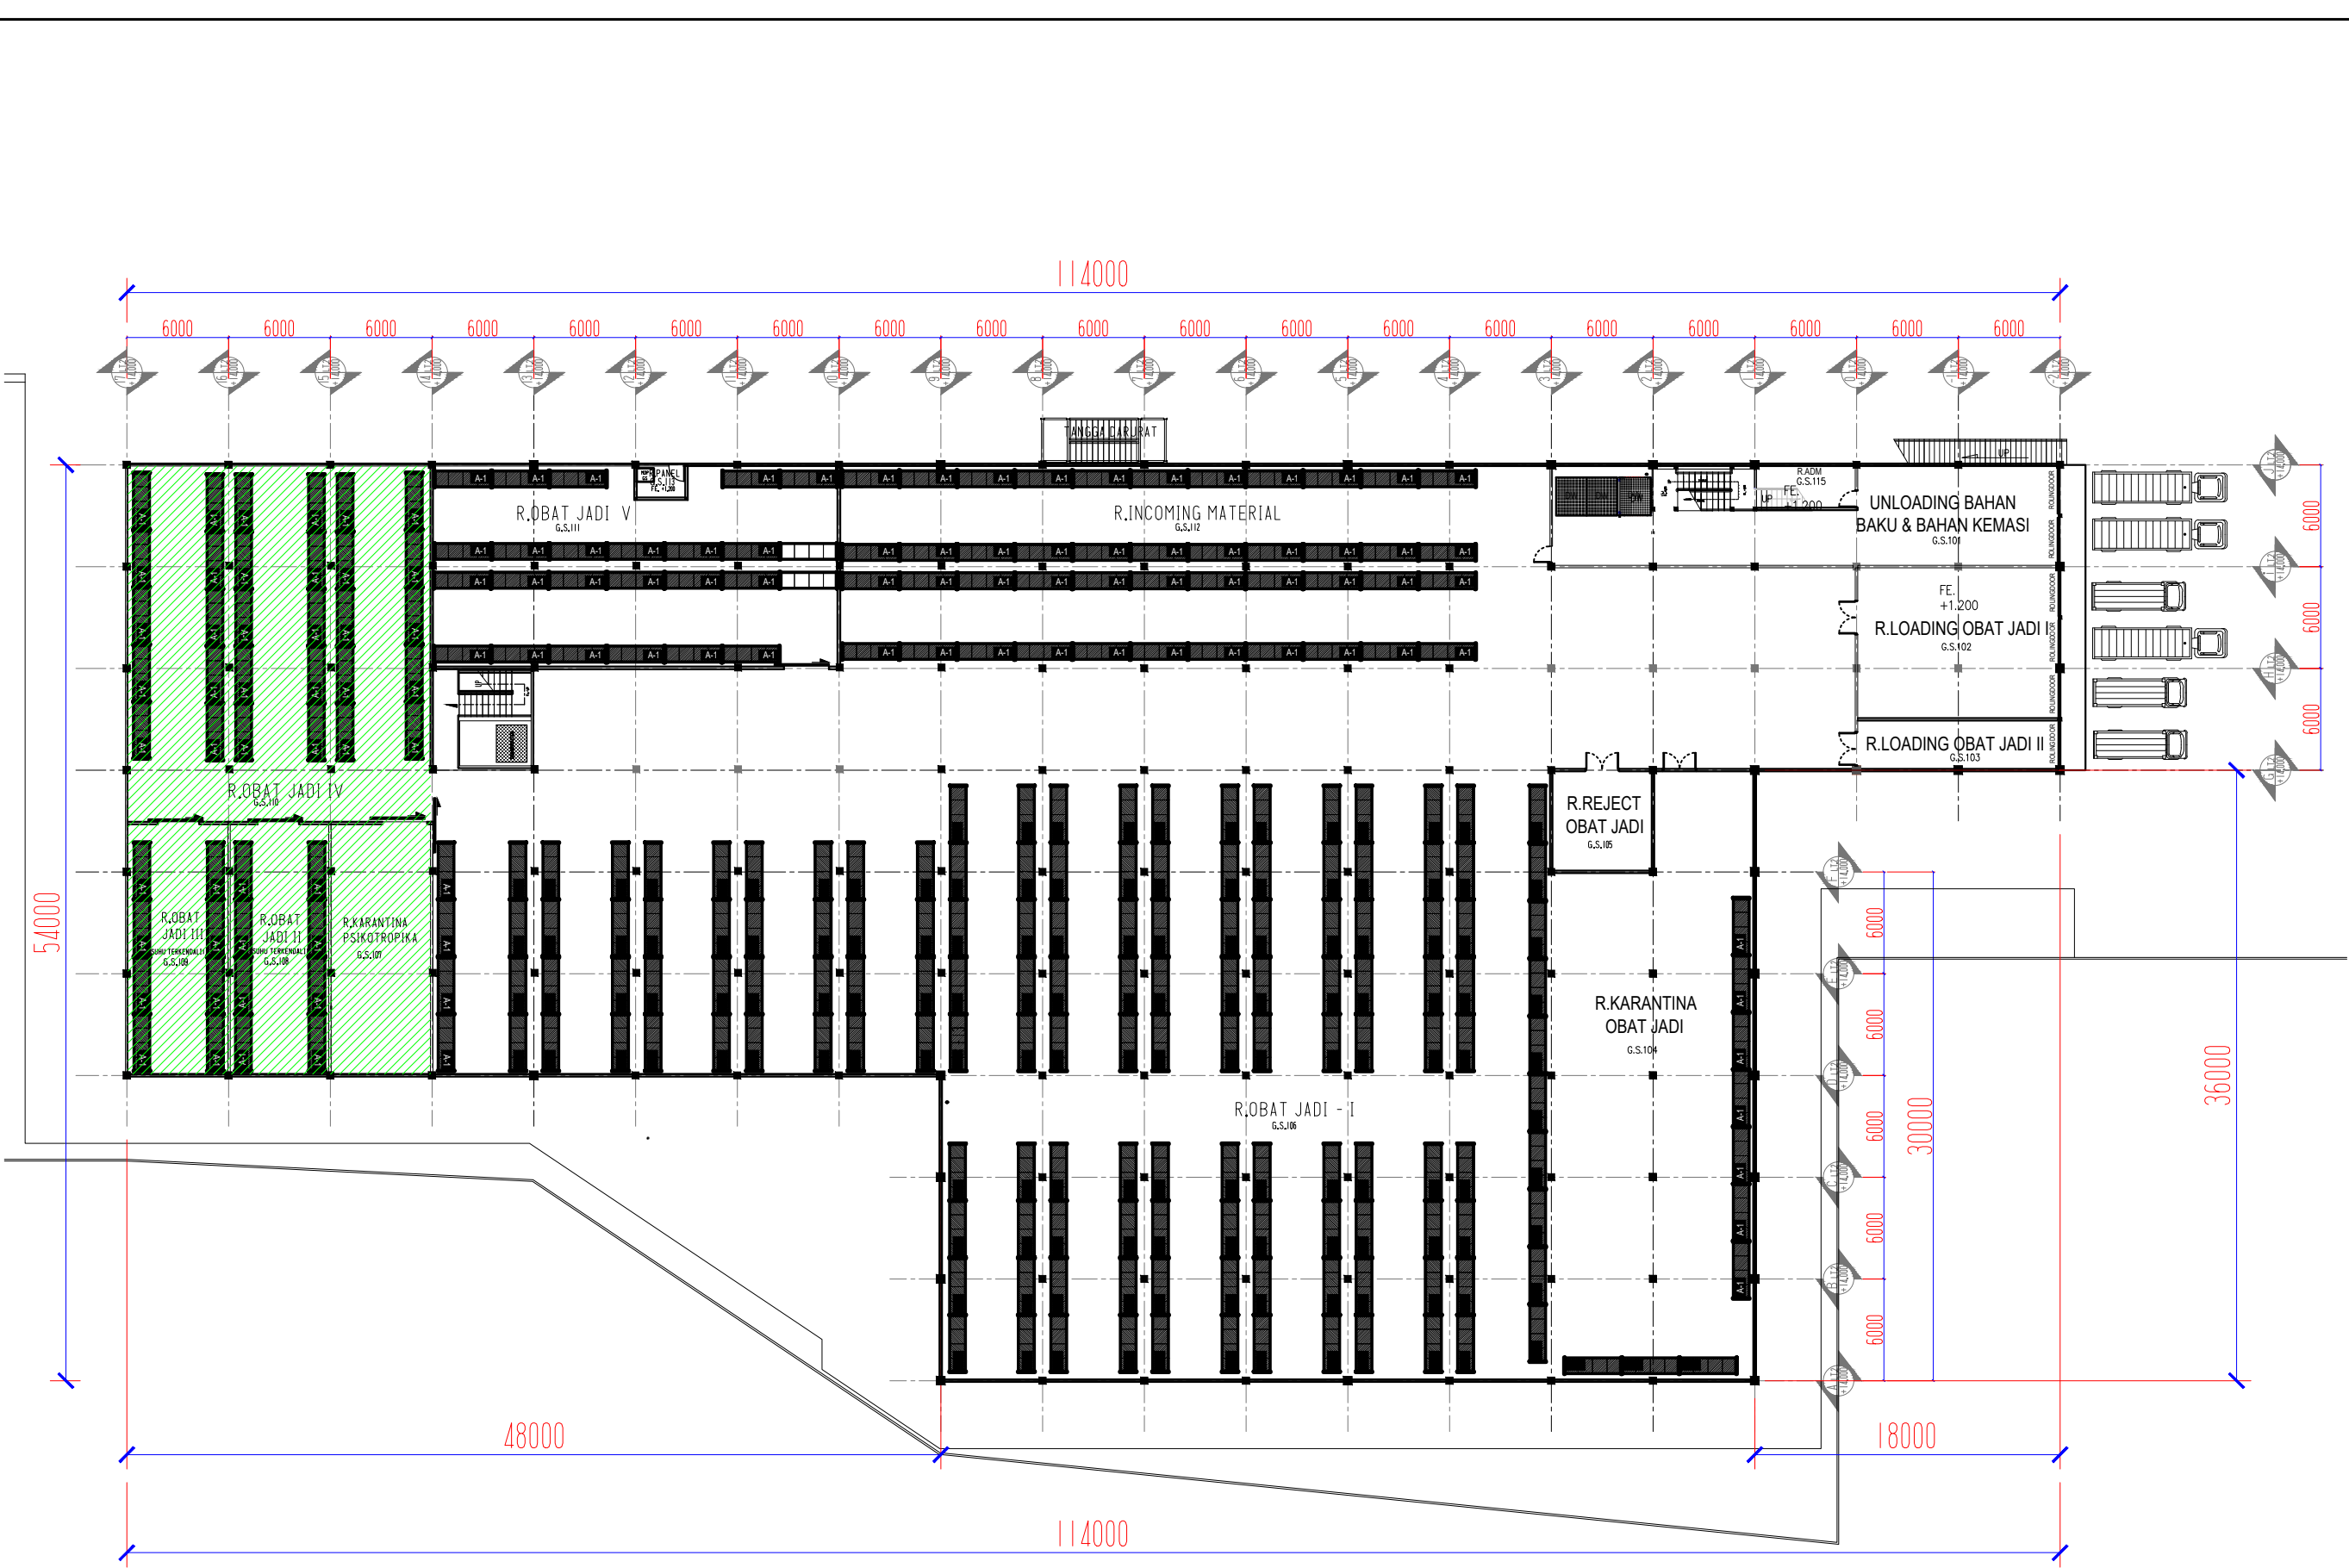

LOKASI
LOCATION

KETERANGAN
LEGEND

NOTASI	KETERANGAN	LUAS
	EPOXY PRIMER 400 MC	648 m ²
	EPOXY FINISHING 850 MC	648 m ²

NO. REFERENSI
REFERENCE NUMBER

TANGGAL

REVISION

Deskripsi revisi :

MANUFAKTUR

Good Quality Improves Life's Quality
SUKABUMI-CIKEMBAR

STATUS GAMBAR
DRAWING STATUS

AS BUILT DRAWING

JUDUL GBR.
DRAWING TITLE

LAYOUT GUDANG SENTRAL LANTAI 1

PROJECT	GUDANG SENTRAL		
	PARAF INITIALS	TANGGAL DATE	UKURAN SIZE
DIGAMBAR DRAWN			A3
DIPERIKSA CHECKED			
DISETUJUI APPROVED			SKALA SCALE
DISETUJUI APPROVED			
DISETUJUI APPROVED			
DISETUJUI APPROVED			
NO. GAMBAR DRAWING NUMBER			REV.
D-A-L-GS.L1-002			01

PRJ. 01-PT/001.00