


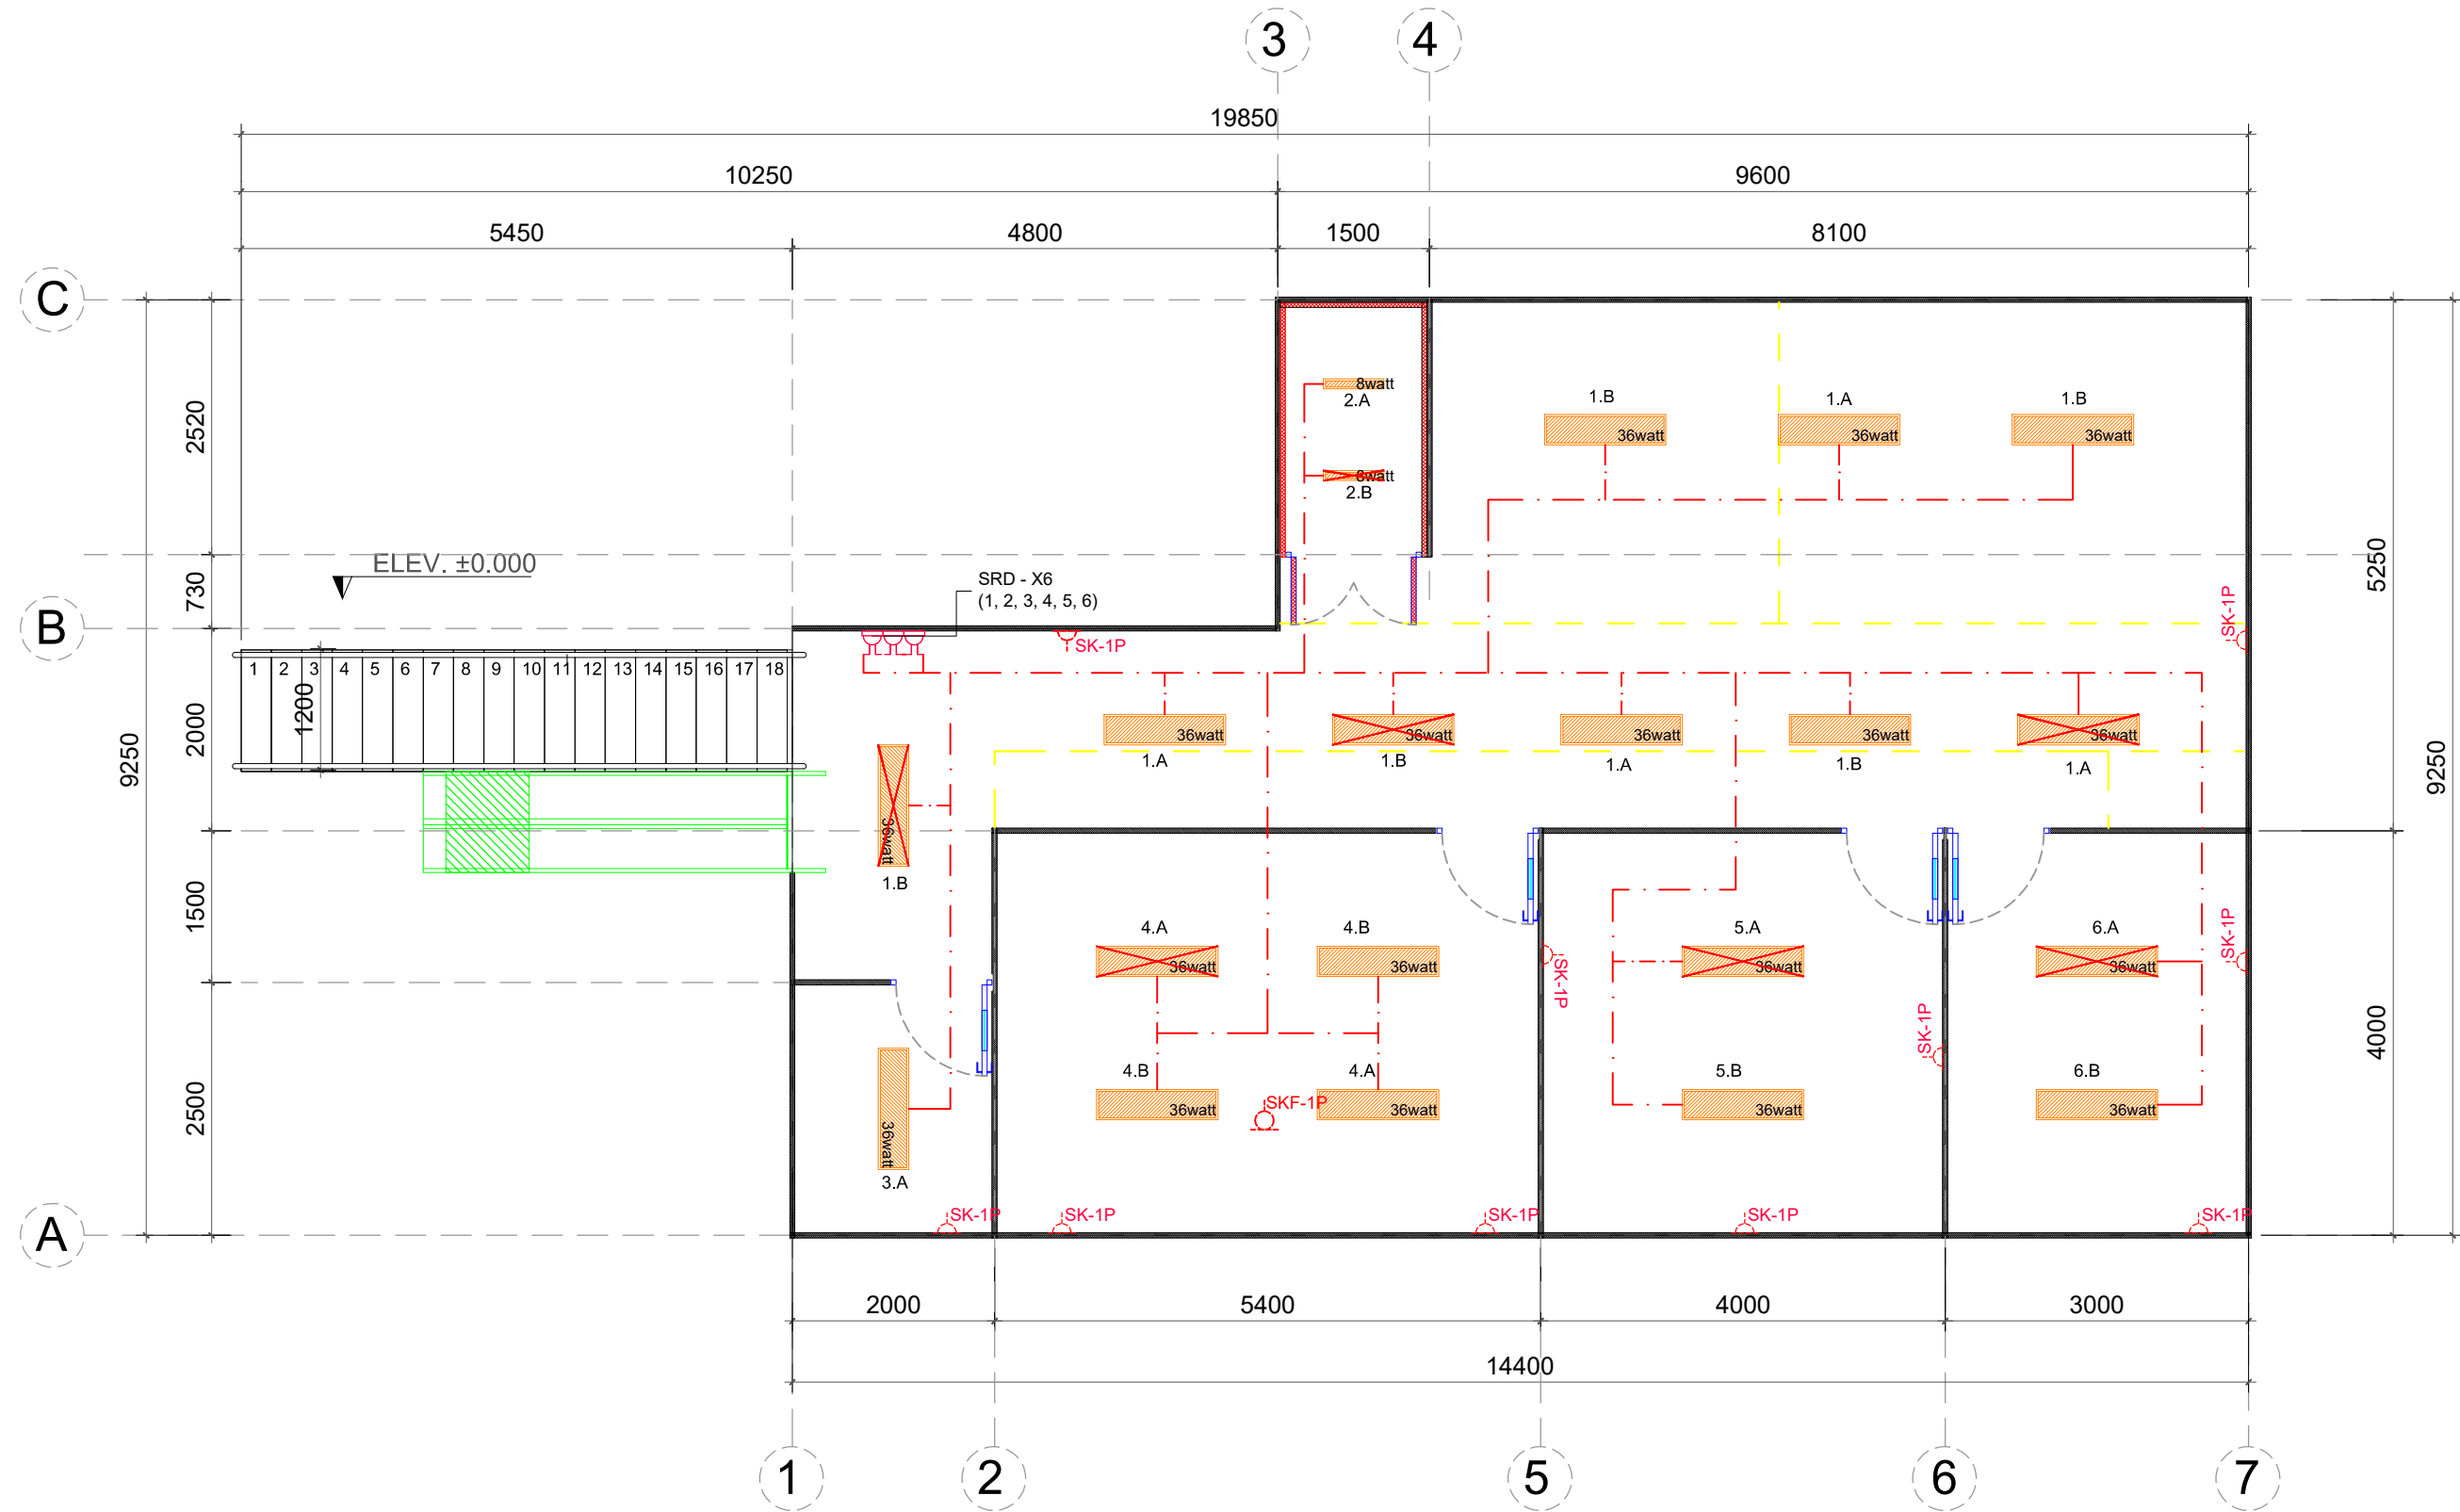

LAYOUT MEZZANINE AREA D
SKALA : N.T.S

LOKASI
LOCATION

KETERANGAN
LEGEND

SIMBOL	KETERANGAN
	STOP KONTAK
	SAKLAR DOUBLE (1 - 6)
	STOP KONTAK FLOOR
	LAMPU TL 46 WATT
	LAMPU TL 46 WATT (EMERGENCY)
	LAMPU TL 8 WATT
	LAMPU TL 8 WATT (EMERGENCY)

NO	NO. REFERENSI REFERENCE NUMBER

NO	TANGGAL	REVISION

Deskripsi revisi :

MANUFATUR

mersi
Good Quality Improves Life's Quality
SUKABUMI-CIKEMBAR

STATUS GAMBAR
DRAWING STATUS

AS-BUILT DRAWING

JUDUL GBR.
DRAWING TITLE

LAYOUT TITIK LAMPU MEZZANINE AREA D

PROJECT	MEZZANINE D		
	PARAF INITIALS	TANGGAL DATE	UKURAN SIZE
DIGAMBAR			A3
DIPERIKSA CHECKED			
DISETUUJUI APPROVED			NTS
DISETUUJUI APPROVED			
DISETUUJUI APPROVED			
DISETUUJUI APPROVED			
NO. GAMBAR DRAWING NUMBER			REV.
D-C-CI-U1NS.MD-001.0			01

PRJ. 01-PT/001.00