


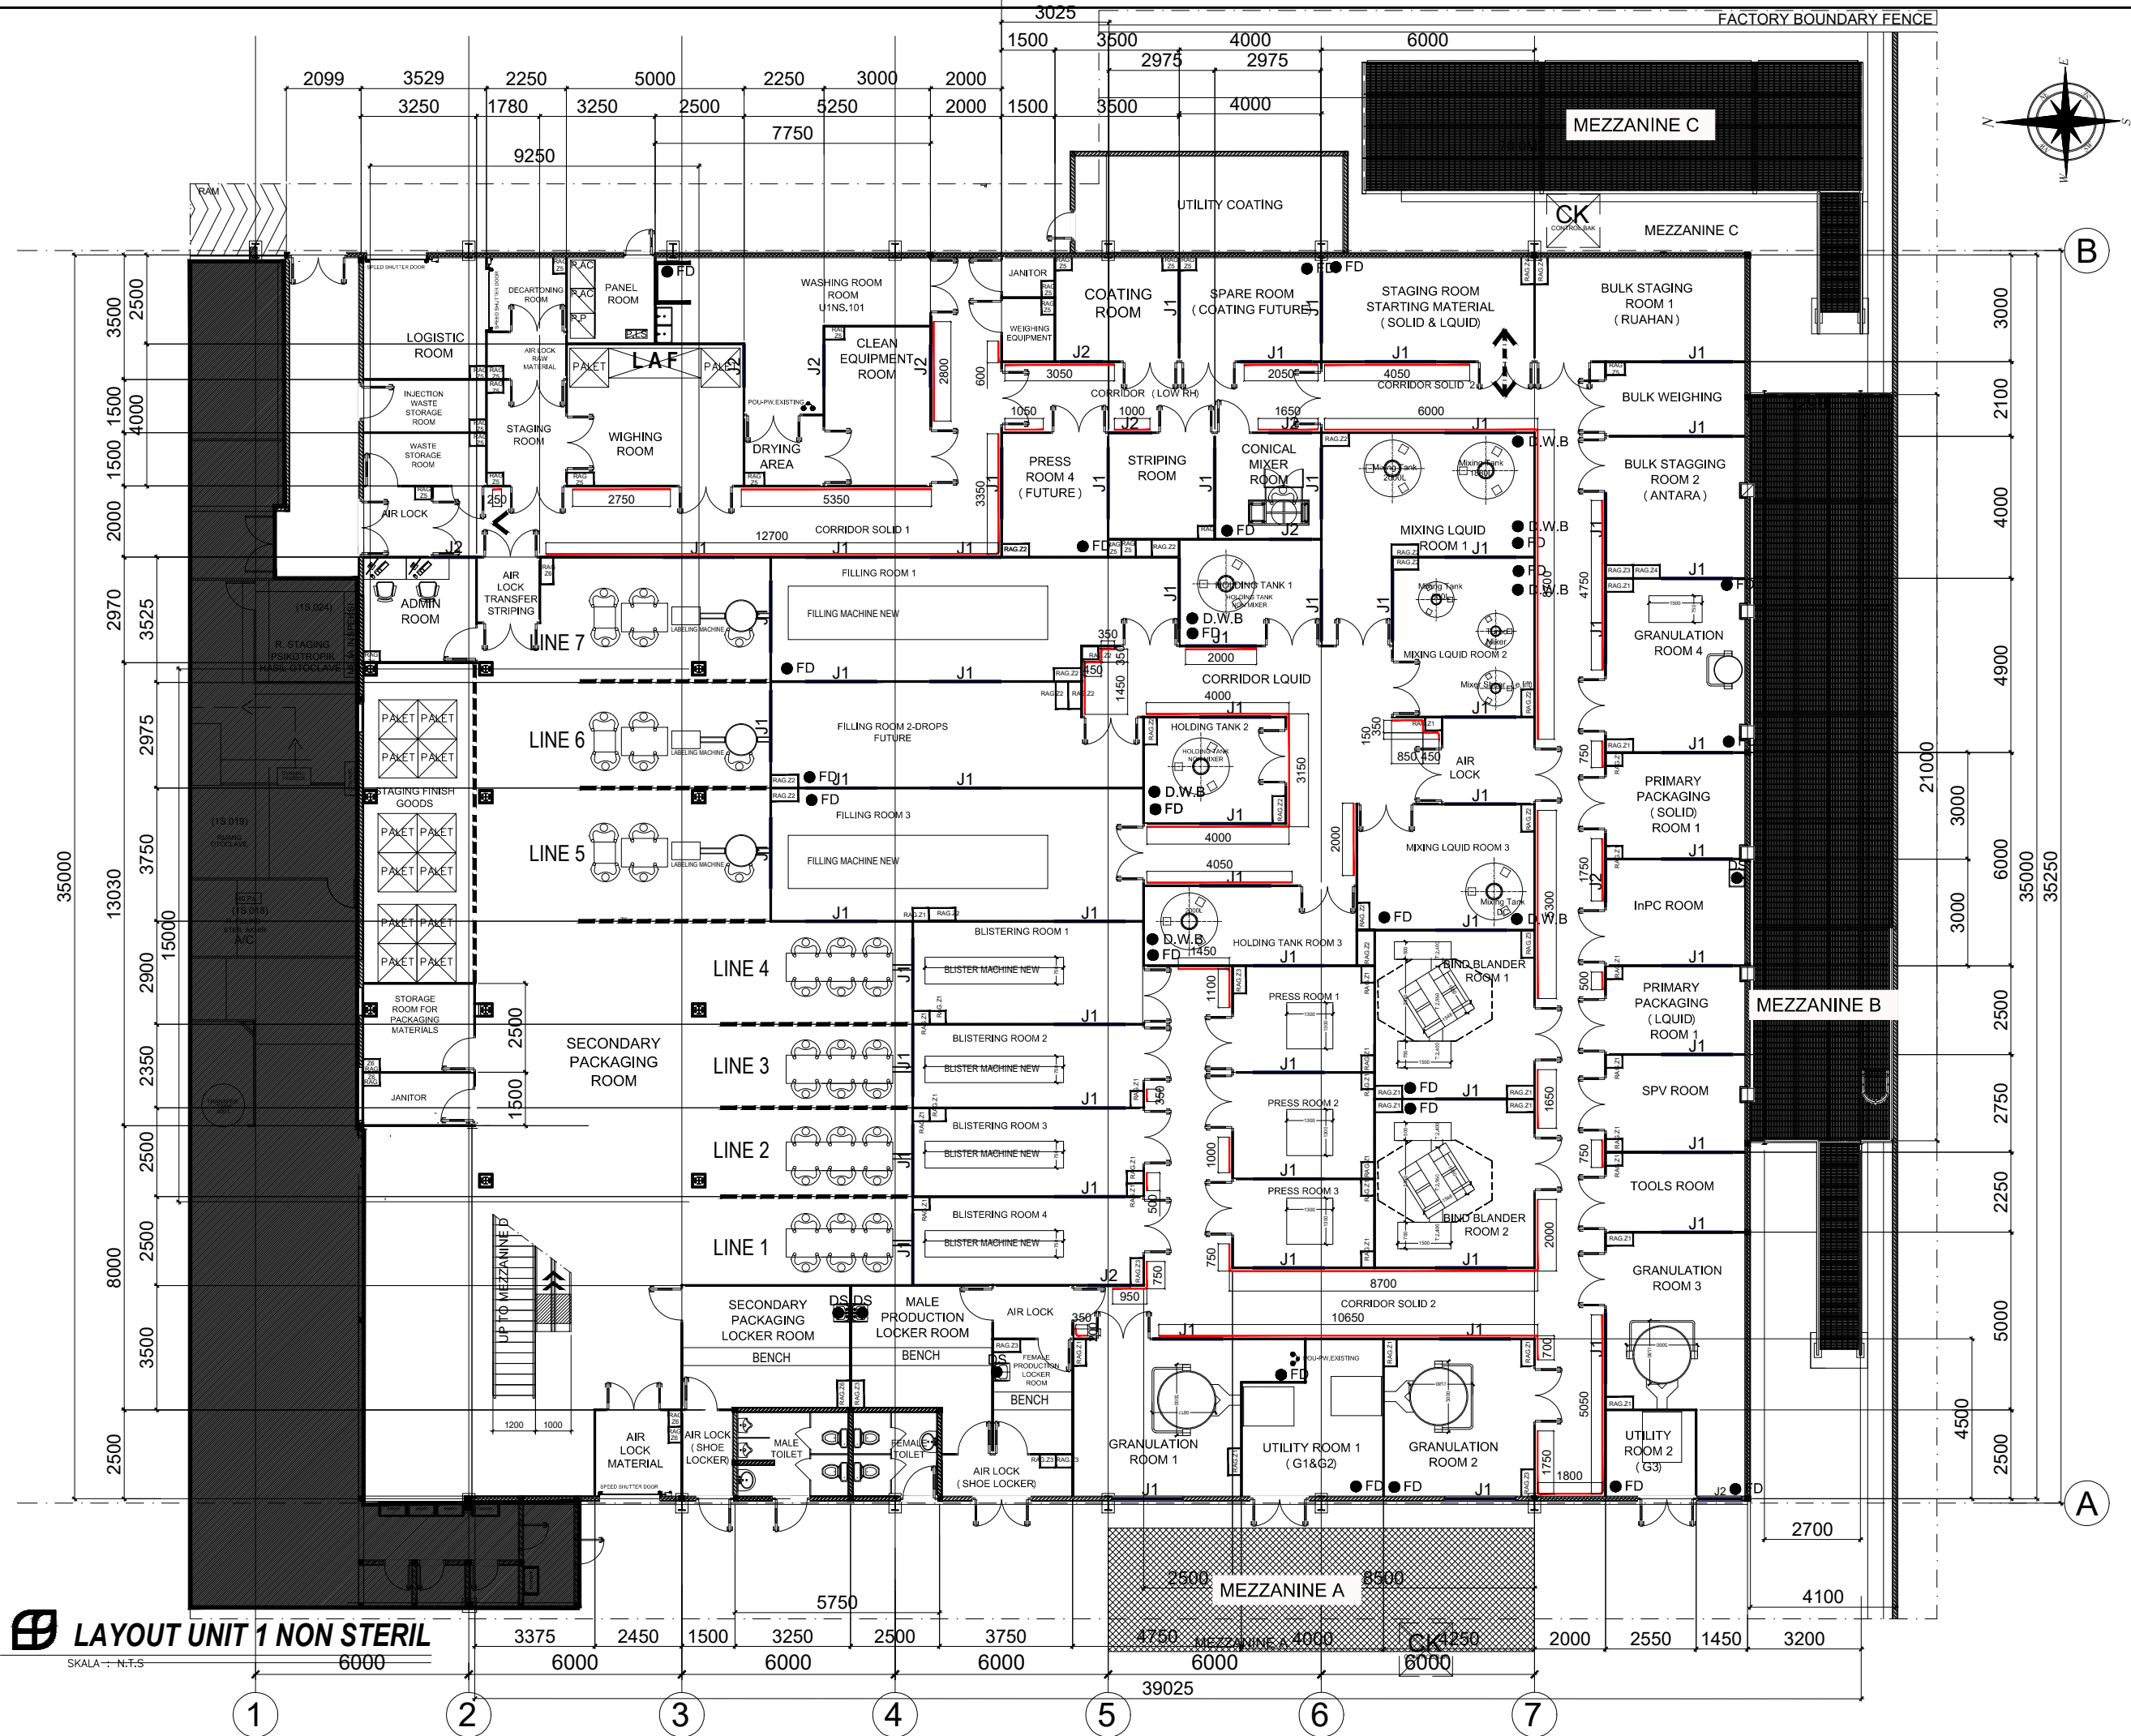

LOKASI  
LOCATION

KETERANGAN  
LEGEND

DETAIL

TAMPAK ATAS

N/A

|                                                                                                                 |                                   |                                                                                    |
|-----------------------------------------------------------------------------------------------------------------|-----------------------------------|------------------------------------------------------------------------------------|
| NO                                                                                                              | NO. REFERENSI<br>REFERENCE NUMBER |                                                                                    |
| 01                                                                                                              | D-A-L-MF.L1.0001                  |                                                                                    |
| 02                                                                                                              | D-A-L-U1NS.L1.003                 |                                                                                    |
| NO                                                                                                              | TANGGAL                           | REVISION                                                                           |
| 05                                                                                                              | 21/11/25                          | Changes in room dimensions                                                         |
| 04                                                                                                              | 22/10/25                          | addition of 1 low rh HVAC zone for a total of 7 HVAC zones & relocation of 2 rooms |
| Deskripsi revisi :<br>-Changes in room dimensions<br>-Granulation 1 -Washing Room<br>-Granulation 2 -Panel Room |                                   |                                                                                    |
| MANUFAKTUR                                                                                                      |                                   |                                                                                    |
| <br>Good Quality Improves Life's Quality<br>SUKABUMI-CIKEMBAR                                                   |                                   |                                                                                    |
| STATUS GAMBAR<br>DRAWING STATUS                                                                                 |                                   |                                                                                    |
| AS-BUILT DRAWING                                                                                                |                                   |                                                                                    |
| JUDUL GBR.<br>DRAWING TITLE                                                                                     |                                   |                                                                                    |
| LAYOUT UNIT 1 NON STERIL                                                                                        |                                   |                                                                                    |
| PROJECT                                                                                                         | UNIT 1 NON STERIL                 |                                                                                    |
|                                                                                                                 | PARAF<br>INITIALS                 | TANGGAL<br>DATE                                                                    |
| DIGAMBAR                                                                                                        |                                   | UKURAN<br>SIZE                                                                     |
| DIPERIKSA<br>CHECKED                                                                                            |                                   | A3                                                                                 |
| DISETUJUI<br>APPROVED                                                                                           |                                   | SKALA<br>SCALE                                                                     |
| DISETUJUI<br>APPROVED                                                                                           |                                   | NTS                                                                                |
| DISETUJUI<br>APPROVED                                                                                           |                                   |                                                                                    |
| NO. GAMBAR<br>DRAWING NUMBER                                                                                    |                                   | REV.                                                                               |
| D-A-L-U1NS.L1-001.0                                                                                             |                                   | 00                                                                                 |

PRJ. 01-PT/001.00