


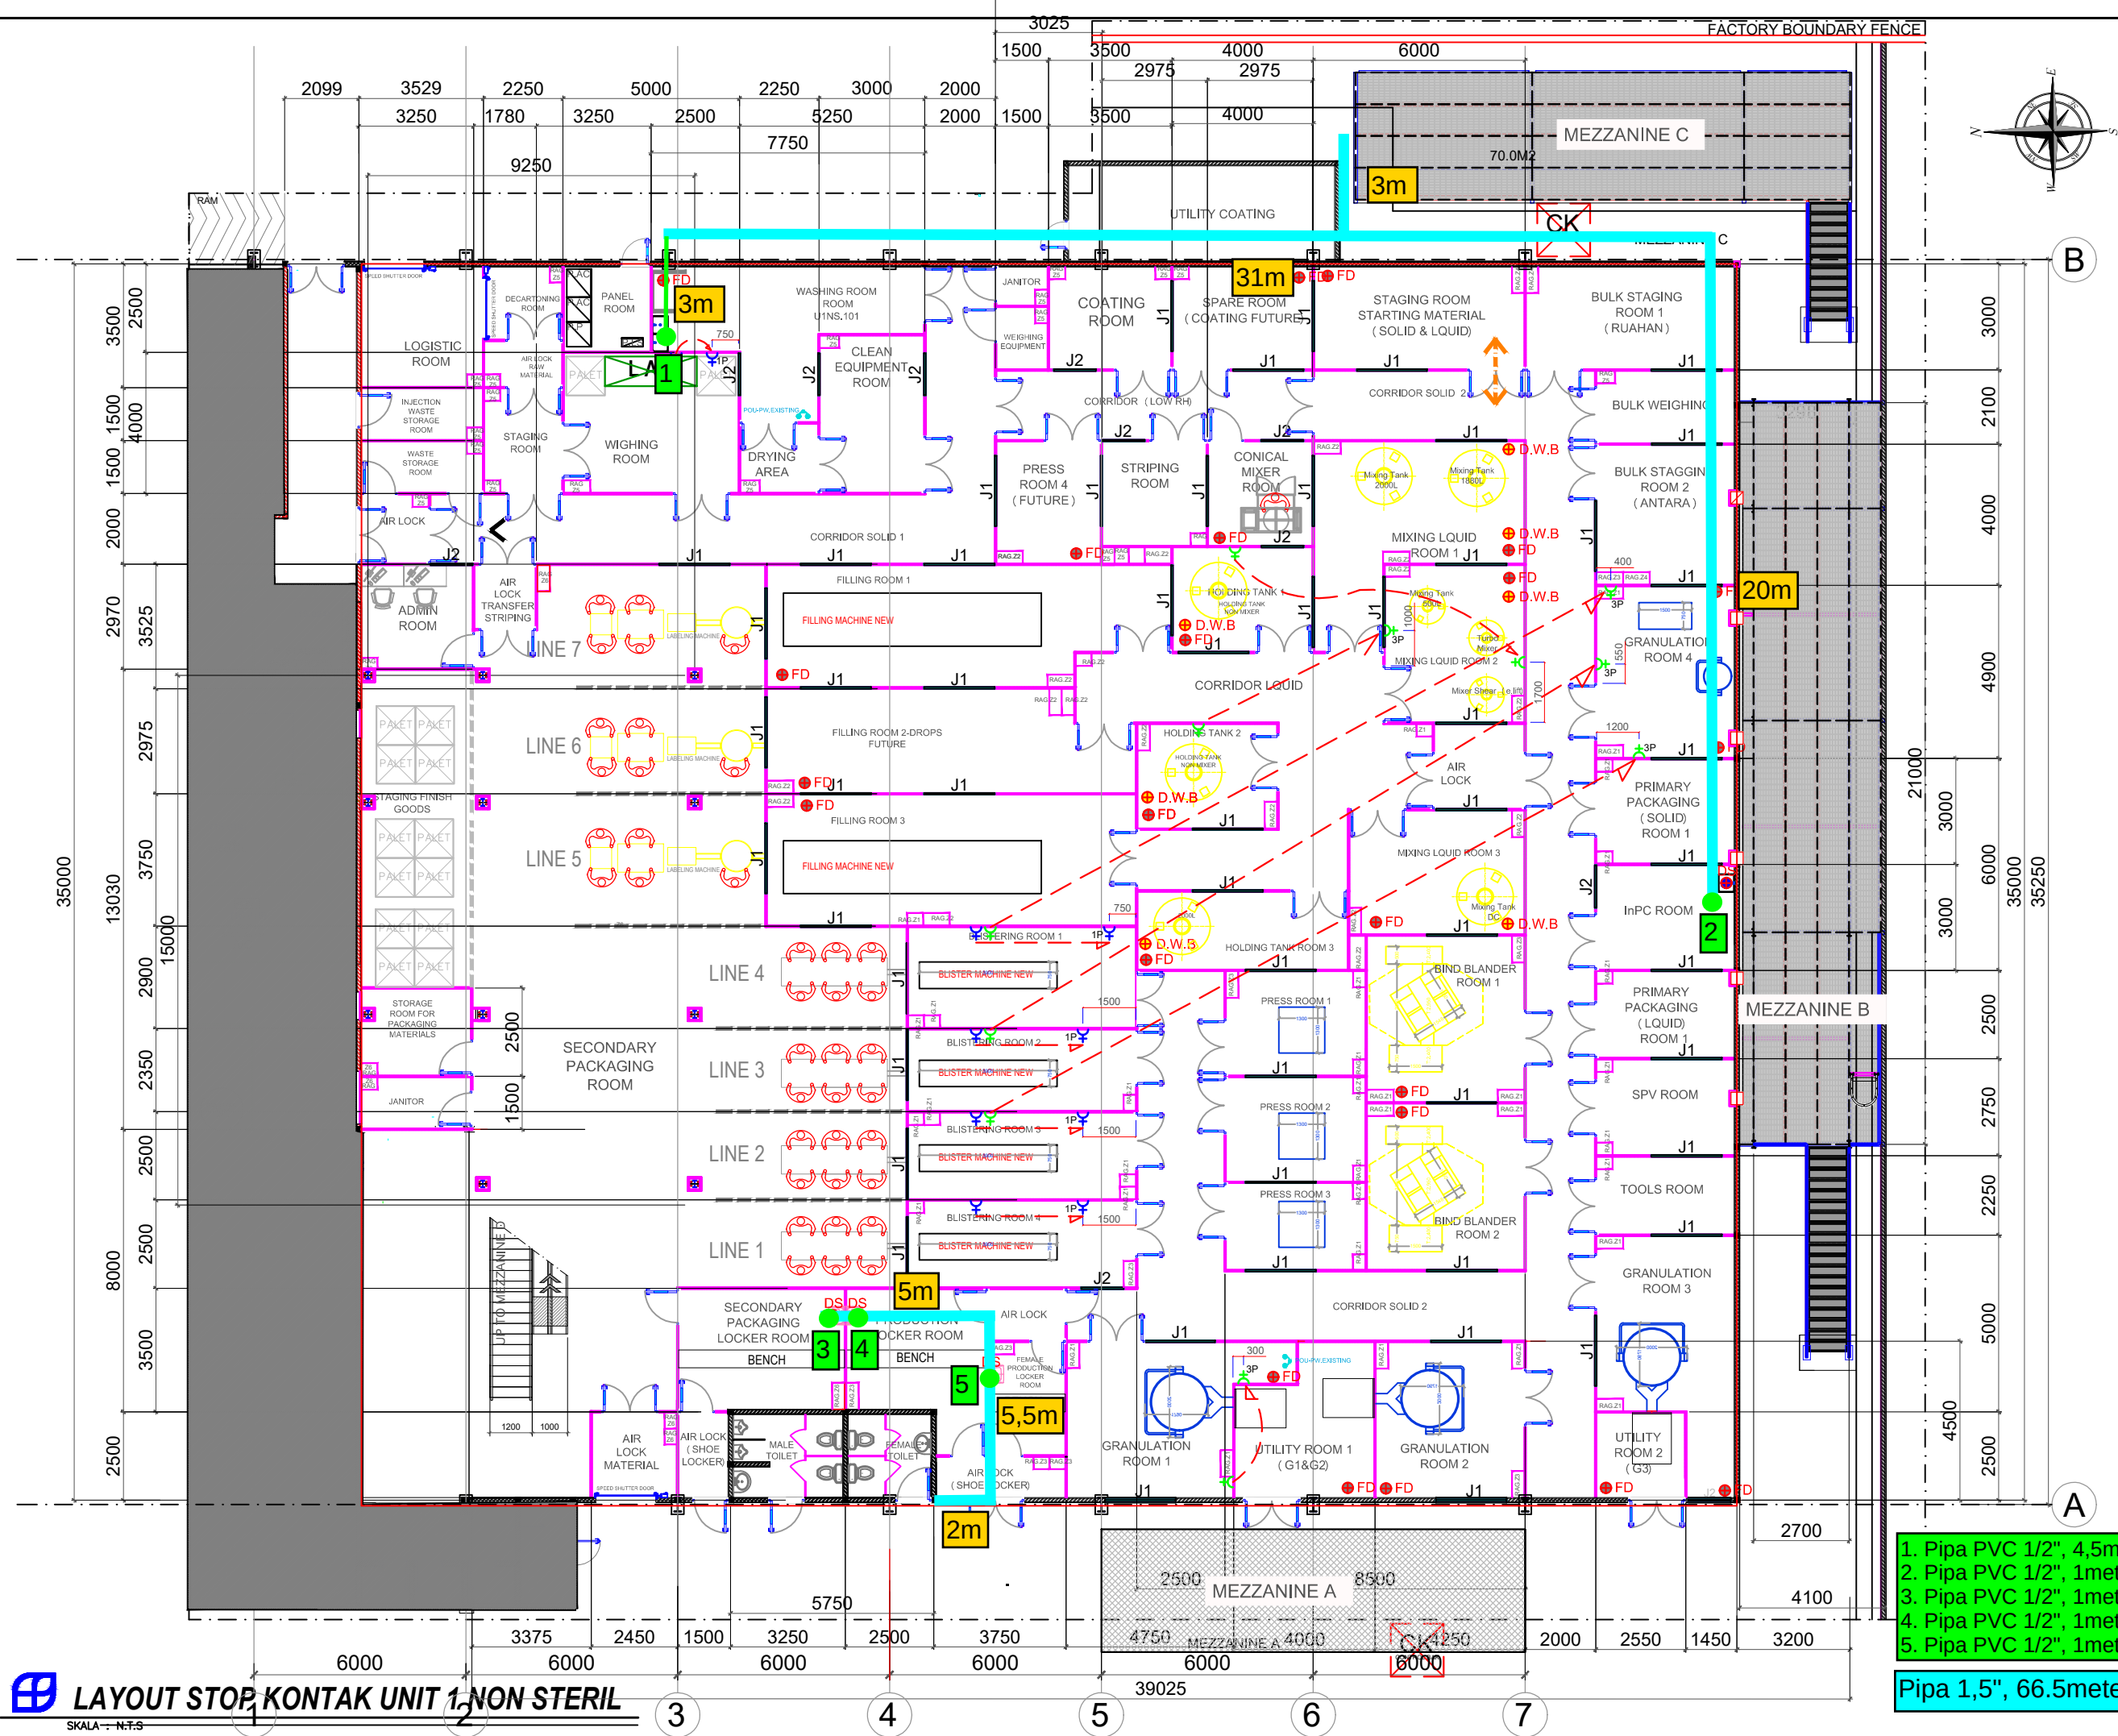

LOKASI
LOCATION

KETERANGAN
LEGEND

STOP KONTAK

= 3 Phase

= 1 Phase

NO

NO. REFERENSI
REFERENCE NUMBER

01

D-A-L-MF.L1.0001

02

D-A-L-U1NS.L1.003

NO

TANGGAL

REVISION

05

21/11/25

Changes in room dimensions

04

22/10/25

addition of 1 low rh HVAC zone for a total of 7 HVAC zones & relocation of 2 rooms

Deskripsi revisi :

Changes in room dimensions
-Granulation 1 -Washing Room
-Granulation 2 -Panel Room

MANFAKTUR

Good Quality Improves Life's Quality
SUKABUMI-CIKEMBAR

STATUS GAMBAR
DRAWING STATUS

AS-BUILT DRAWING

JUDUL GBR.
DRAWING TITLE

LAYOUT STOP KONTAK UNIT 1 NON STERIL

PROJECT

UNIT 1 NON STERIL

DIGAMBAR

DIPERIKSA
CHECKED

DISETUJUI
APPROVED

DISETUJUI
APPROVED

DISETUJUI
APPROVED

PARAF
INITIALS

TANGGAL
DATE

UKURAN
SIZE

A3

SKALA
SCALE

NTS

NO. GAMBAR
DRAWING NUMBER

REV.

D-A-L-U1NS.L1-001.0

00

PRJ. 01-PT/001.00

1. Pipa PVC 1/2", 4,5meter
2. Pipa PVC 1/2", 1meter
3. Pipa PVC 1/2", 1meter
4. Pipa PVC 1/2", 1meter
5. Pipa PVC 1/2", 1meter
- Pipa 1,5", 66.5meter