


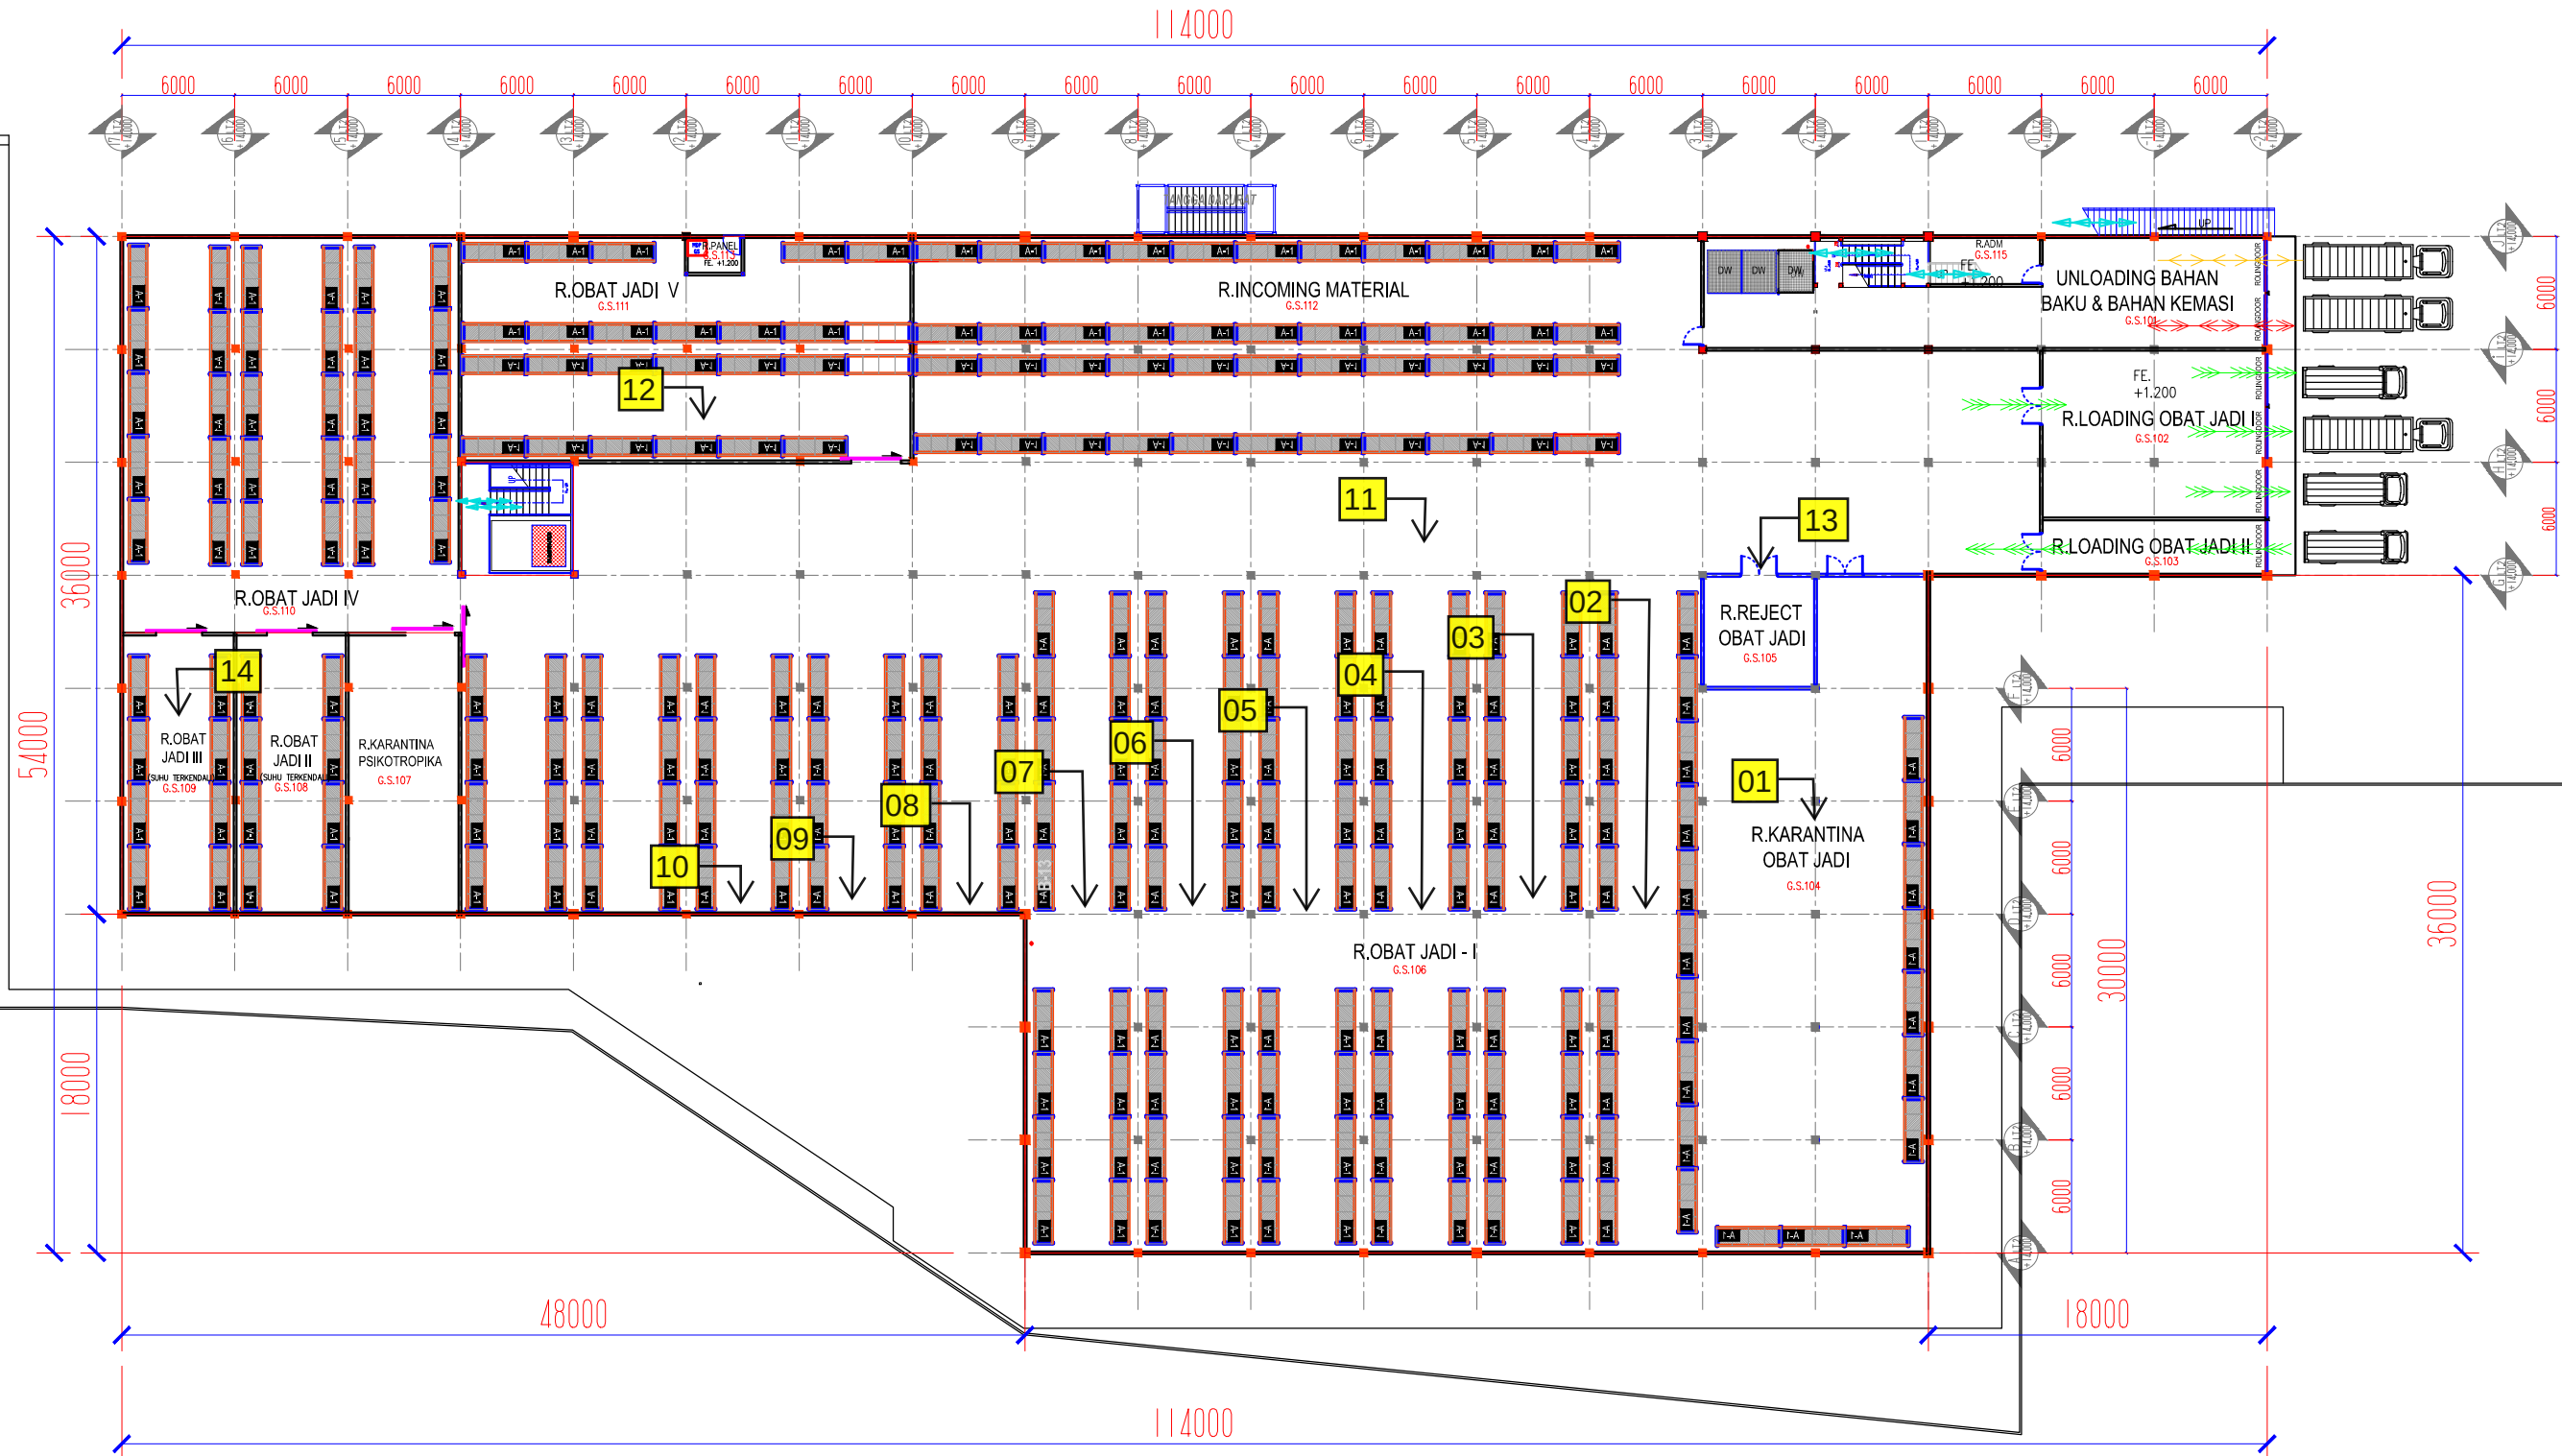

LOKASI
LOCATION

KETERANGAN
LEGEND

NOTASI	KETERANGAN
	ALUR ORANG
	ALUR BAHAN KEMAS
	ALUR BAHAN BAKU
	ALUR OBAT JADI

NO. REFERENSI
REFERENCE NUMBER

01 D-A-L-MF.L1-001

TANGGAL

01 20-10-24

REVISION

685/MFG/LOG/PP/X/24

Deskripsi revisi :
perubahan fungsi ruang

N/A

MANUFAKTUR

Good Quality Improves Life's Quality
SUKABUMI-CIKEMBAR

STATUS GAMBAR
DRAWING STATUS

AS BUILT DRAWING

JUDUL GBR.
DRAWING TITLE

LAYOUT GUDANG SENTRAL LANTAI 1

PROJECT	GUDANG SENTRAL		
	PARAF INITIALS	TANGGAL DATE	UKURAN SIZE
DIGAMBAR DRAWN			A3
DIPERIKSA CHECKED			
DISETUJUI APPROVED			SKALA SCALE
DISETUJUI APPROVED			
DISETUJUI APPROVED			
NO. GAMBAR DRAWING NUMBER			REV.
D-A-L-GS.L1-002			01

LAYOUT GUDANG SENTRAL LANTAI 1
SCALA : N.T.S

PRODUCED BY AN AUTODESK EDUCATIONAL PRODUCT

PRJ. 01-PT/001.00