





KETERANGAN
LEGEND

AREA	KETERANGAN
4843 M2	BANGUNAN

N/A

010-A-L-MF.L1-001

01 20-10-24.085/MFG/LOG/PP/N/24

Desain oleh :
Pembuatan fungsi ruang

N/A


Bmersi
Good Quality Improves Life's Quality
SUKABUMI-CIKEMBAR

AS BUILT DRAWING

LAYOUT GUDANG SENTRAL LANTAI 1

PROJECT	GUDANG SENTRAL LANTAI 1
SCALE	1:100
DATE	2024/10/24
DESIGNER	ADRIAN
CHECKER	ADRIAN
APPROVER	ADRIAN
REVISION	01
STATUS	NTS
NO.	D-A-L-GS.L1-002
PRJ.	01-PIT/001.00

: lantai Epoxi Rucat

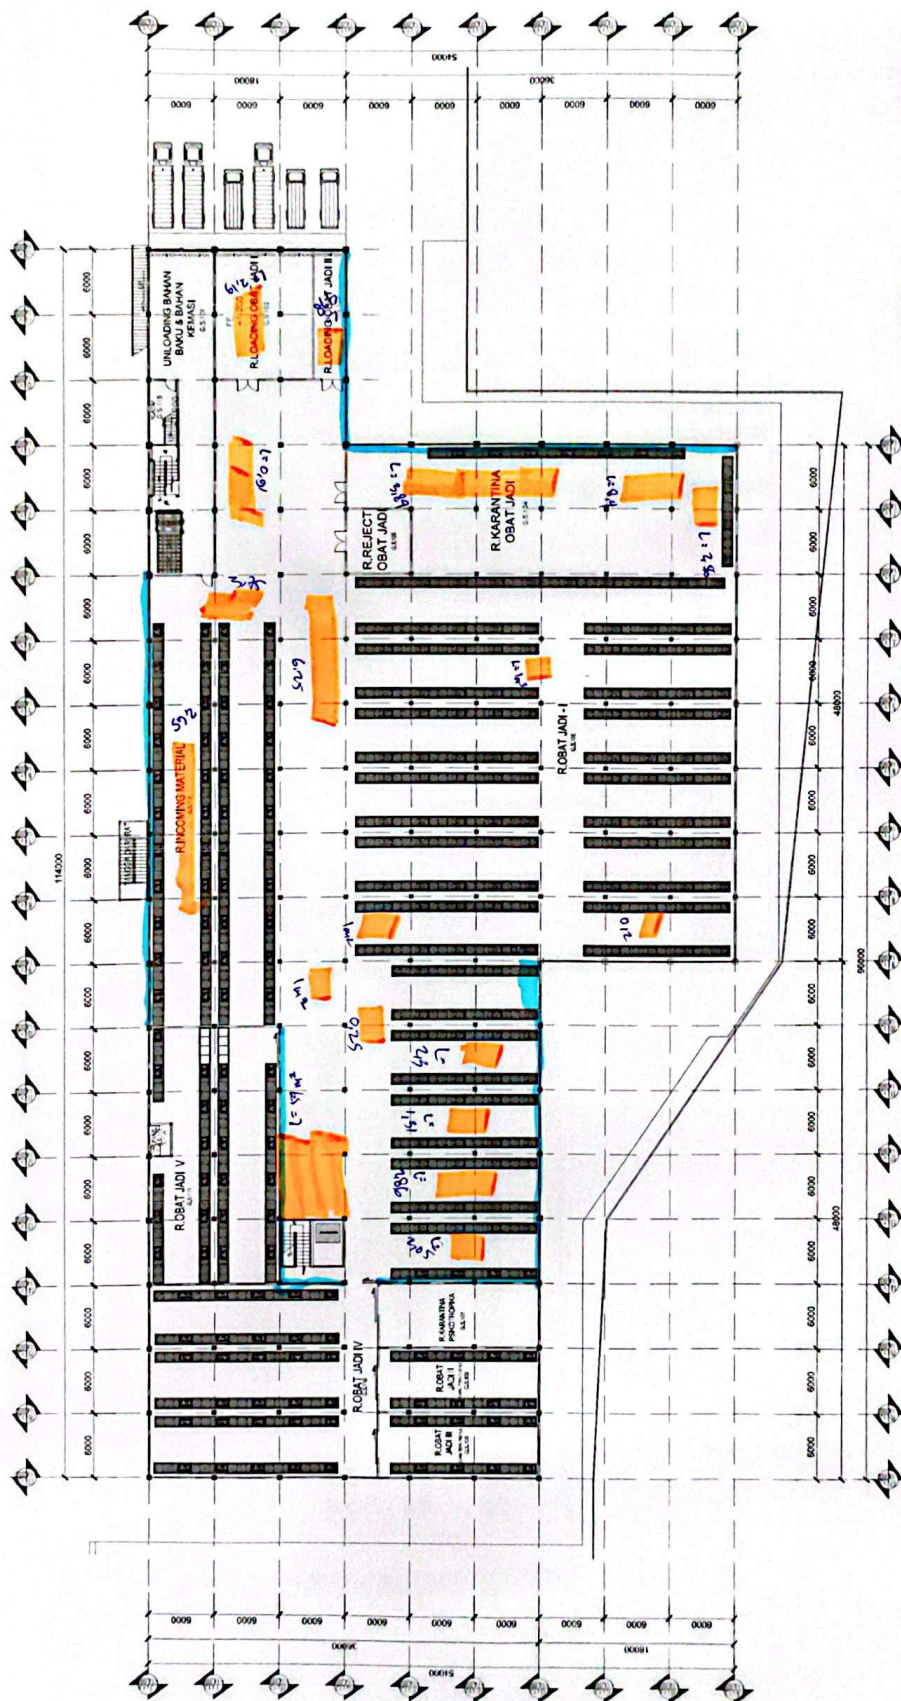

LAYOUT GUDANG SENTRAL LANTAI 1

SCALE : N.T.S



KETERANGAN
LEGEND

LUAS	KETERANGAN
4870 M2	BANGUNAN

N/A

11	D-A-L-MF.L1-001
----	-----------------

--	--

20-10-24	685	MFG/LOG/PP/X/24
----------	-----	-----------------

1

N/A

mersi
Good Quality Improves Life's Quality
SUKABUMI - CIKEMBAR

VG


LAYOUT GUIDANG SENTRAL LANTAI 2



53

NTS

DATE	01
DESCRIPTION	D-A-L-GS.L2-003
PRJ	01-PT/001.00

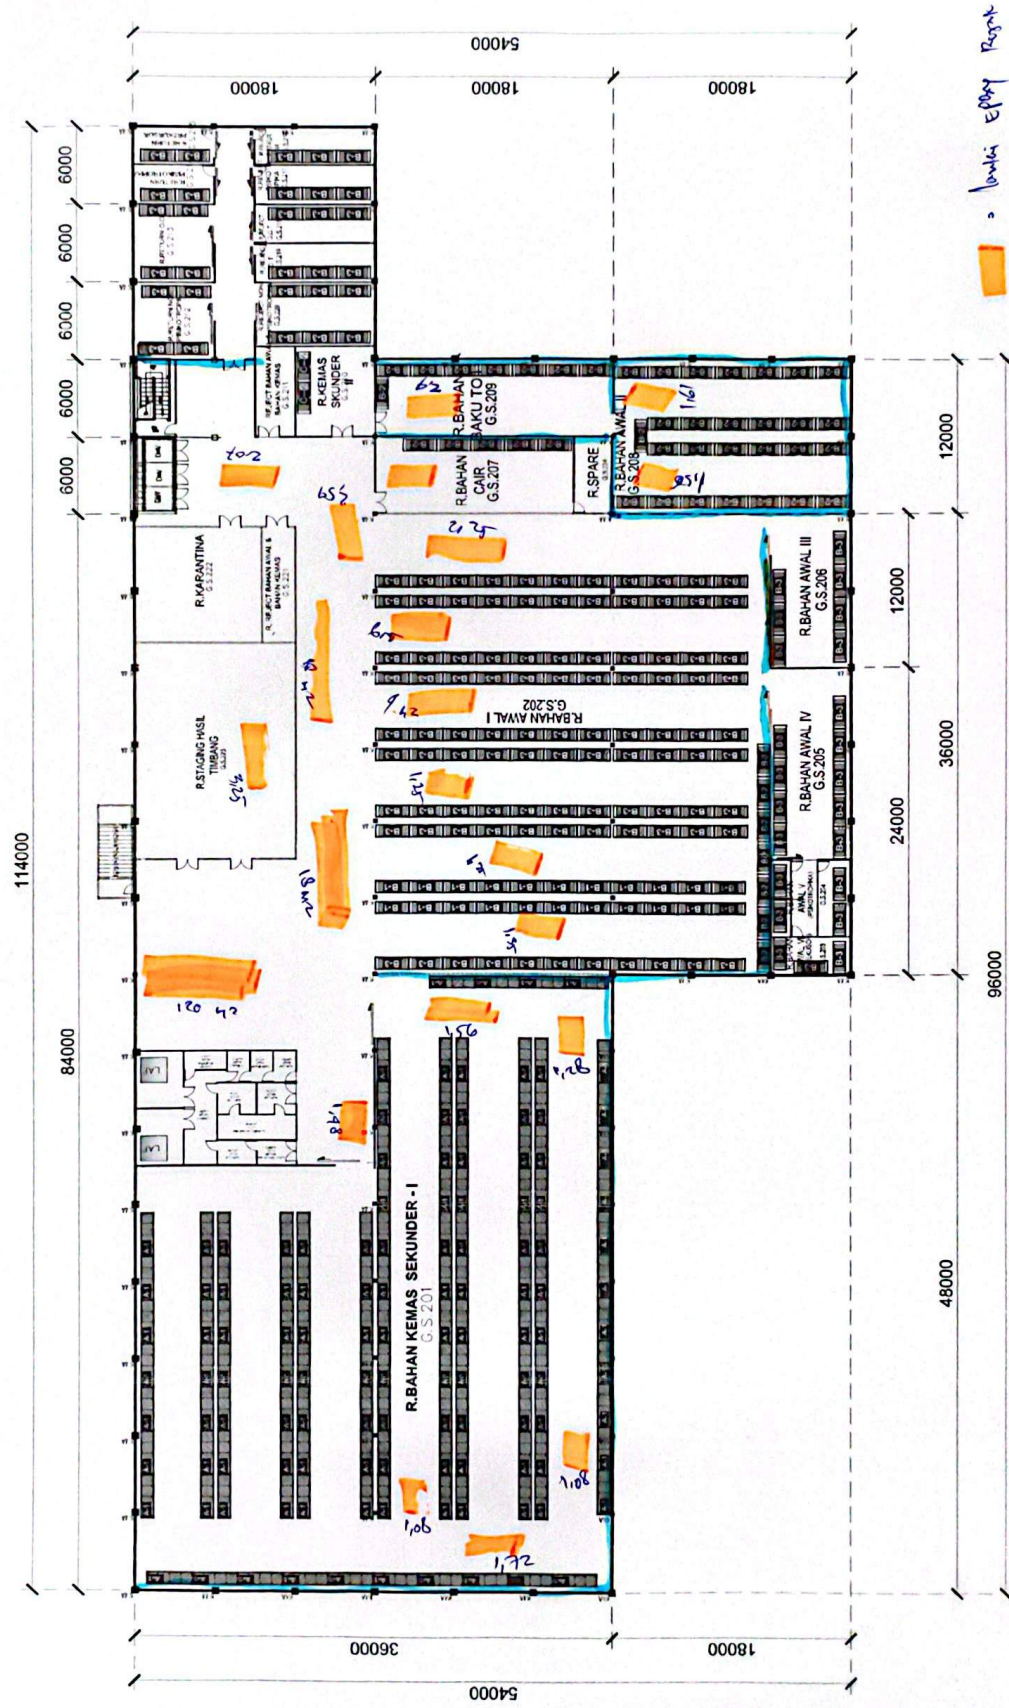

• lambic Epoxy Resin

 LAYOUT GUDANG SENTRAL LANTAI 2

SCALA : N.T.S