


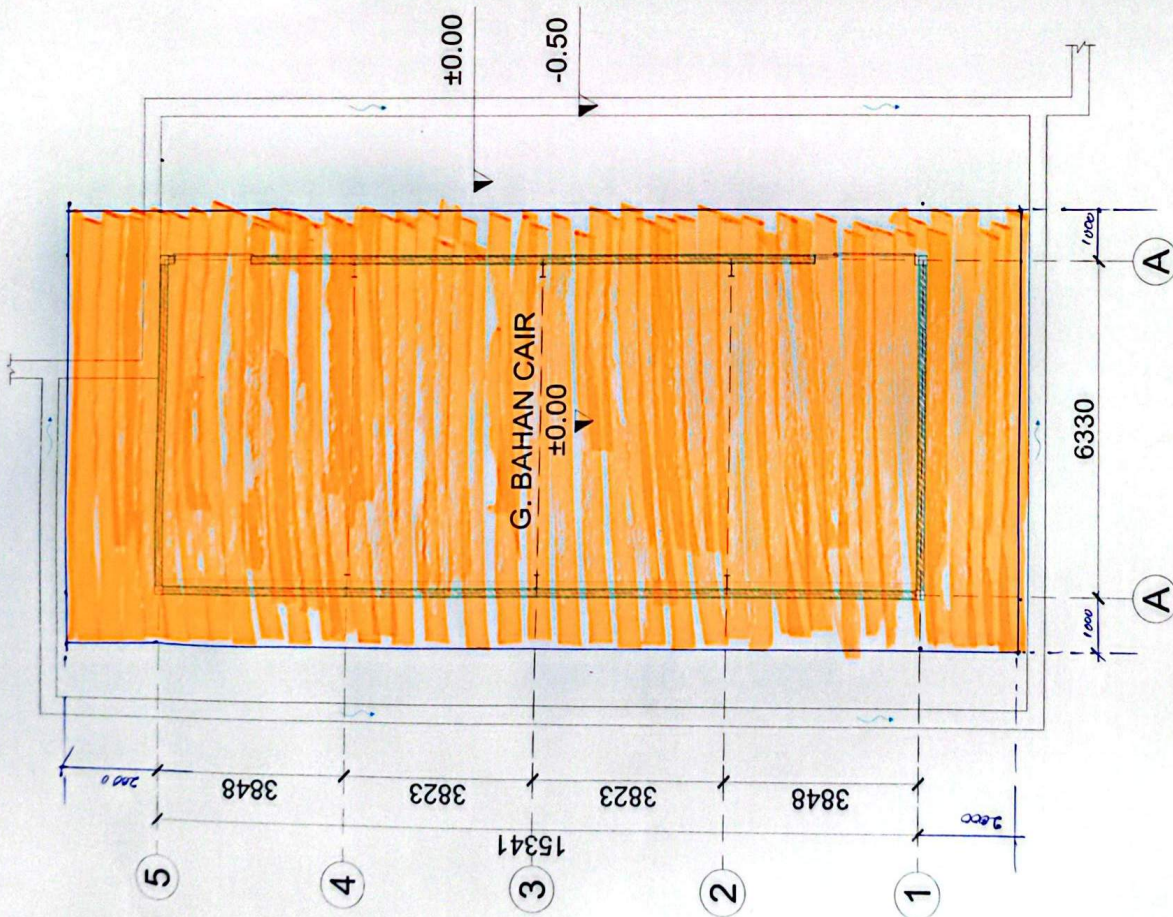


: Area Dik G. Bahan Cair

LAYOUT GUDANG BAHAN CAIR

SKALA : N.T.S

LOKASI
LOCATION

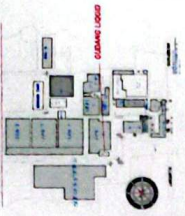

KETERANGAN
LEGEND

AREA	KETERANGAN
01 M2	BAHUTAN

N/A

NO

01

NO

REVISI

Desain: ...

N/A

mersi
Good Quality Improves Life's Quality

SUKABUMI-CIKEMBAR

AS BUILT DRAWING

LAYOUT GUDANG BAHAN CAIR

PROJECT

GUJANG BAHAN CAIR

PROJECT

PROJECT

