


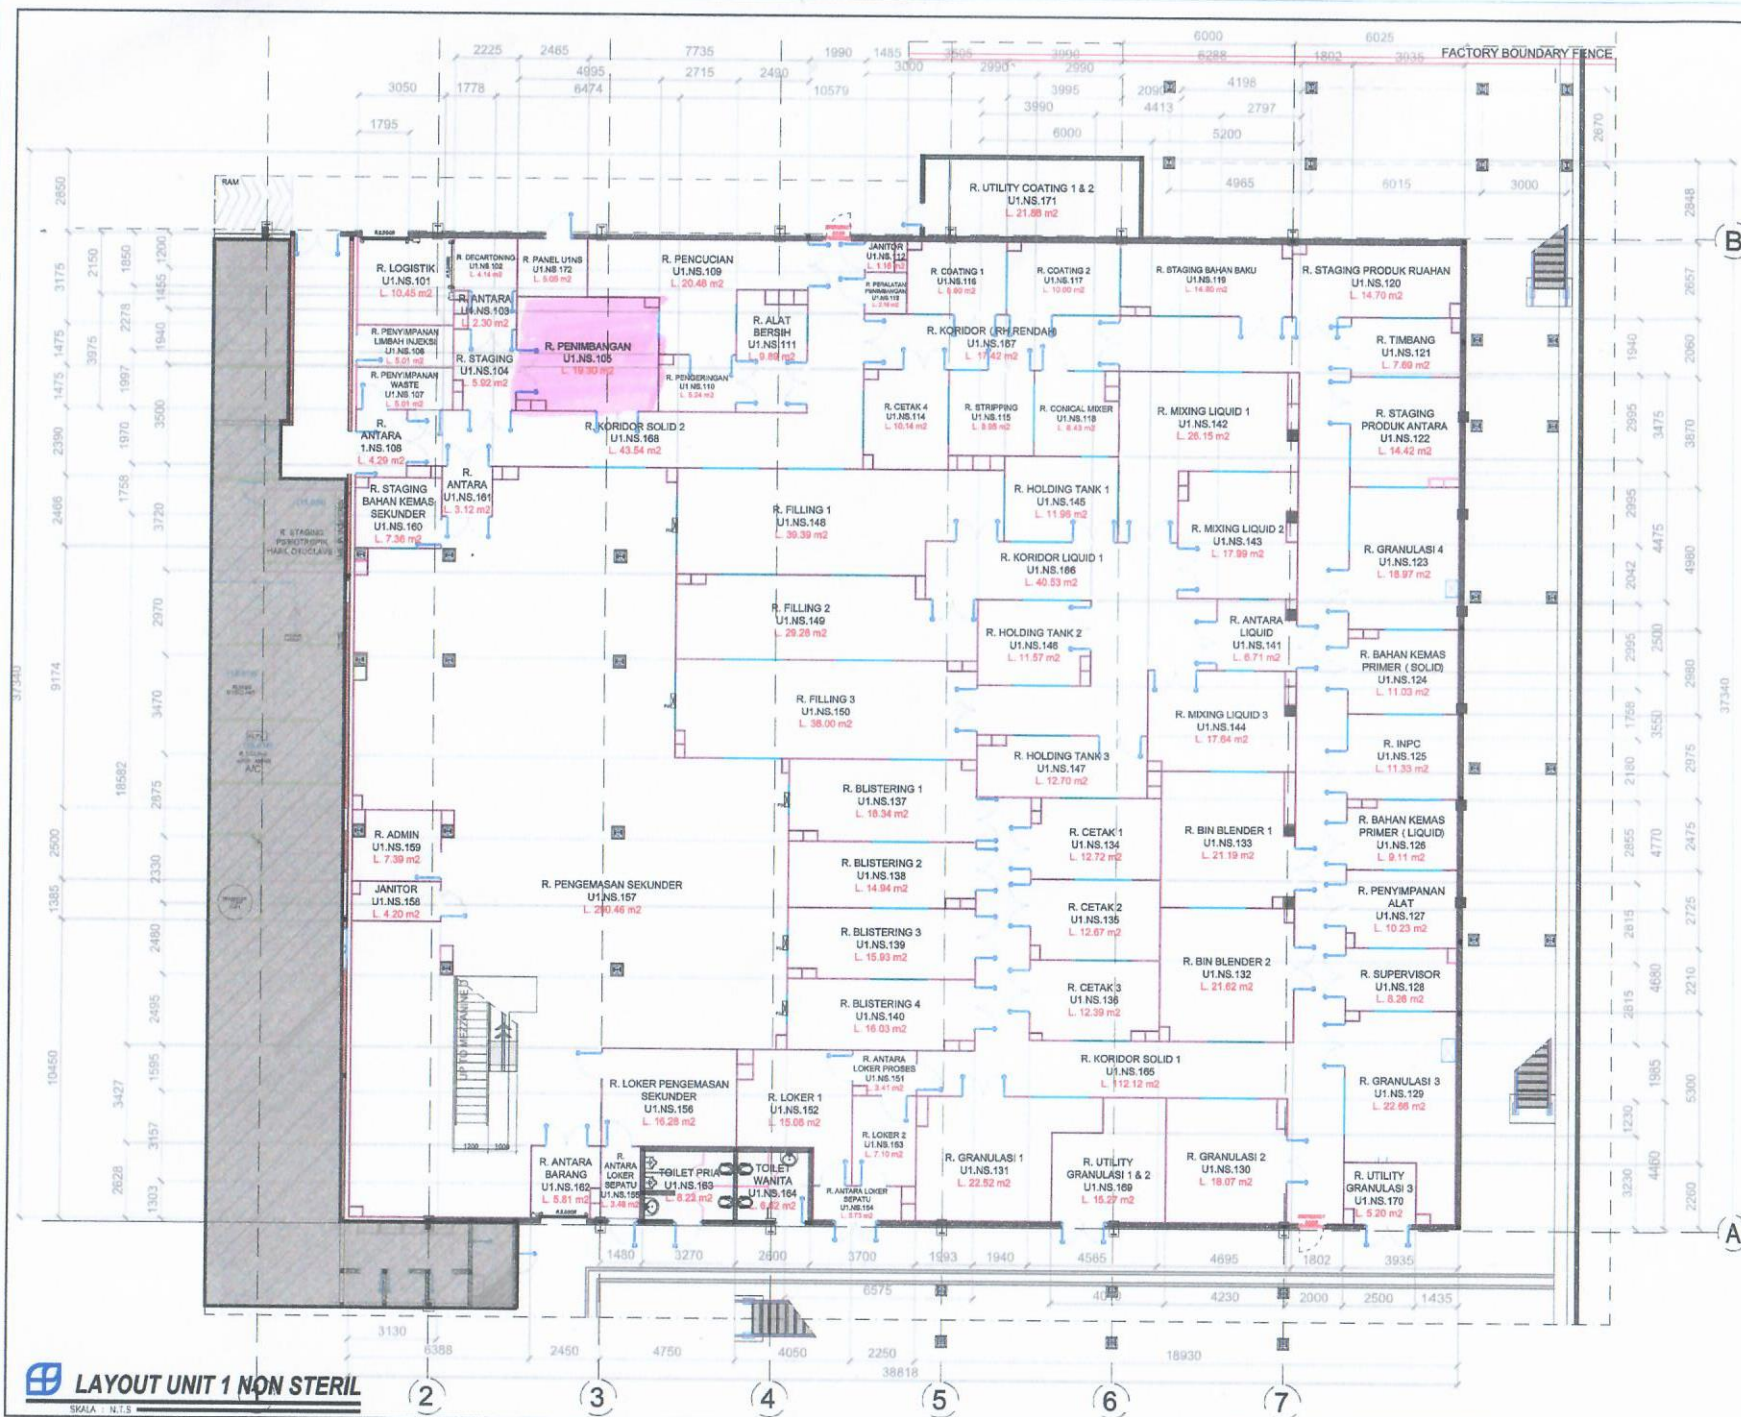

LAYOUT UNIT 1 NON STERIL

LOKASI



KETERANGAN

- Luas Bangunan: 1385,0 m2
01. Fasilitas Proses Produksi & Kemas Sekunder
03. Fasilitas Utilitas (Utility)
04. Fasilitas Toilet

N/A

NO. REVISI

01 D-A-L-MF.L1.0001

02 D-A-L-U1.NS.L1.003

NO. JENJAL

REVISI

Detail revisi :

MANUFACTUR

mersi
Good Quality Improves Life's Quality
SUKABUMI-CIKEMBAR

STERIL GAMBAR

AS-BUILT DRAWING

REVISI

00

UNIT 1 NON STERIL

PROJECT

UNIT 1 NON STERIL

REVISI

00

REVISI

00

