



KETERANGAN

N/A

N/A




SUKABUMI—CIKEMBAR

AS BUILT DRAWING


ENAH BAK NO 8

PROJECT	WVTP 8			JULIAN NO.
	DATE	TIME	TIME	
20080801				A3
20080802				NTS
20080803				NTS
20080804				NTS
20080805				NTS

D-HSE-HS-IPAL-B-LI-006.6

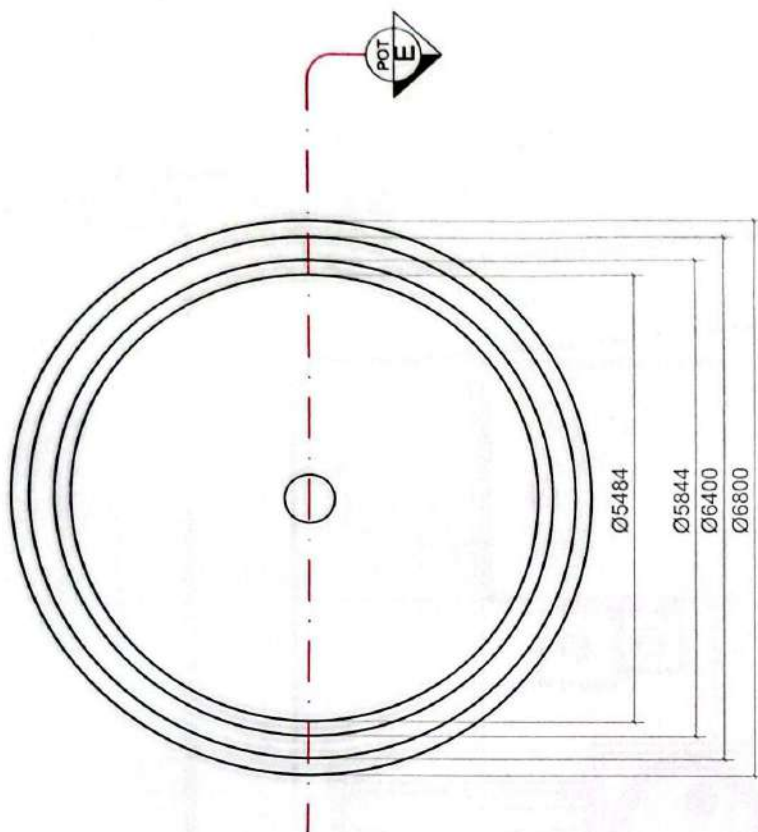


DENAH BAK NO 8

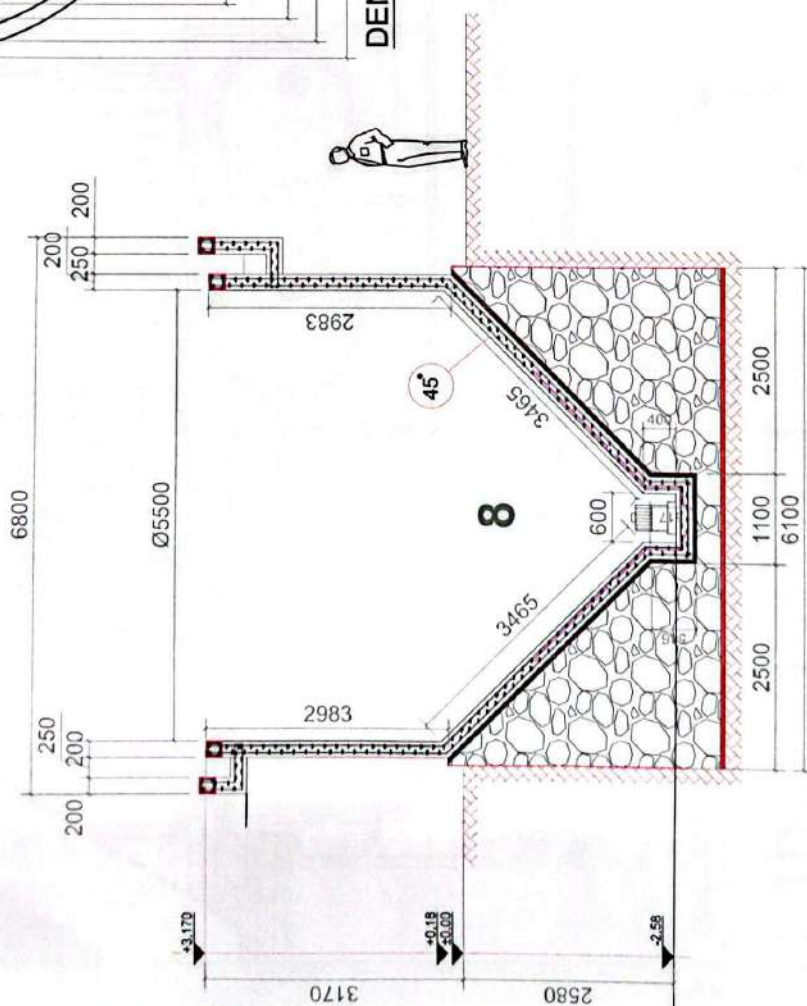

DENAH TAMPAK POTONGAN E



DENAH BAK NO 8

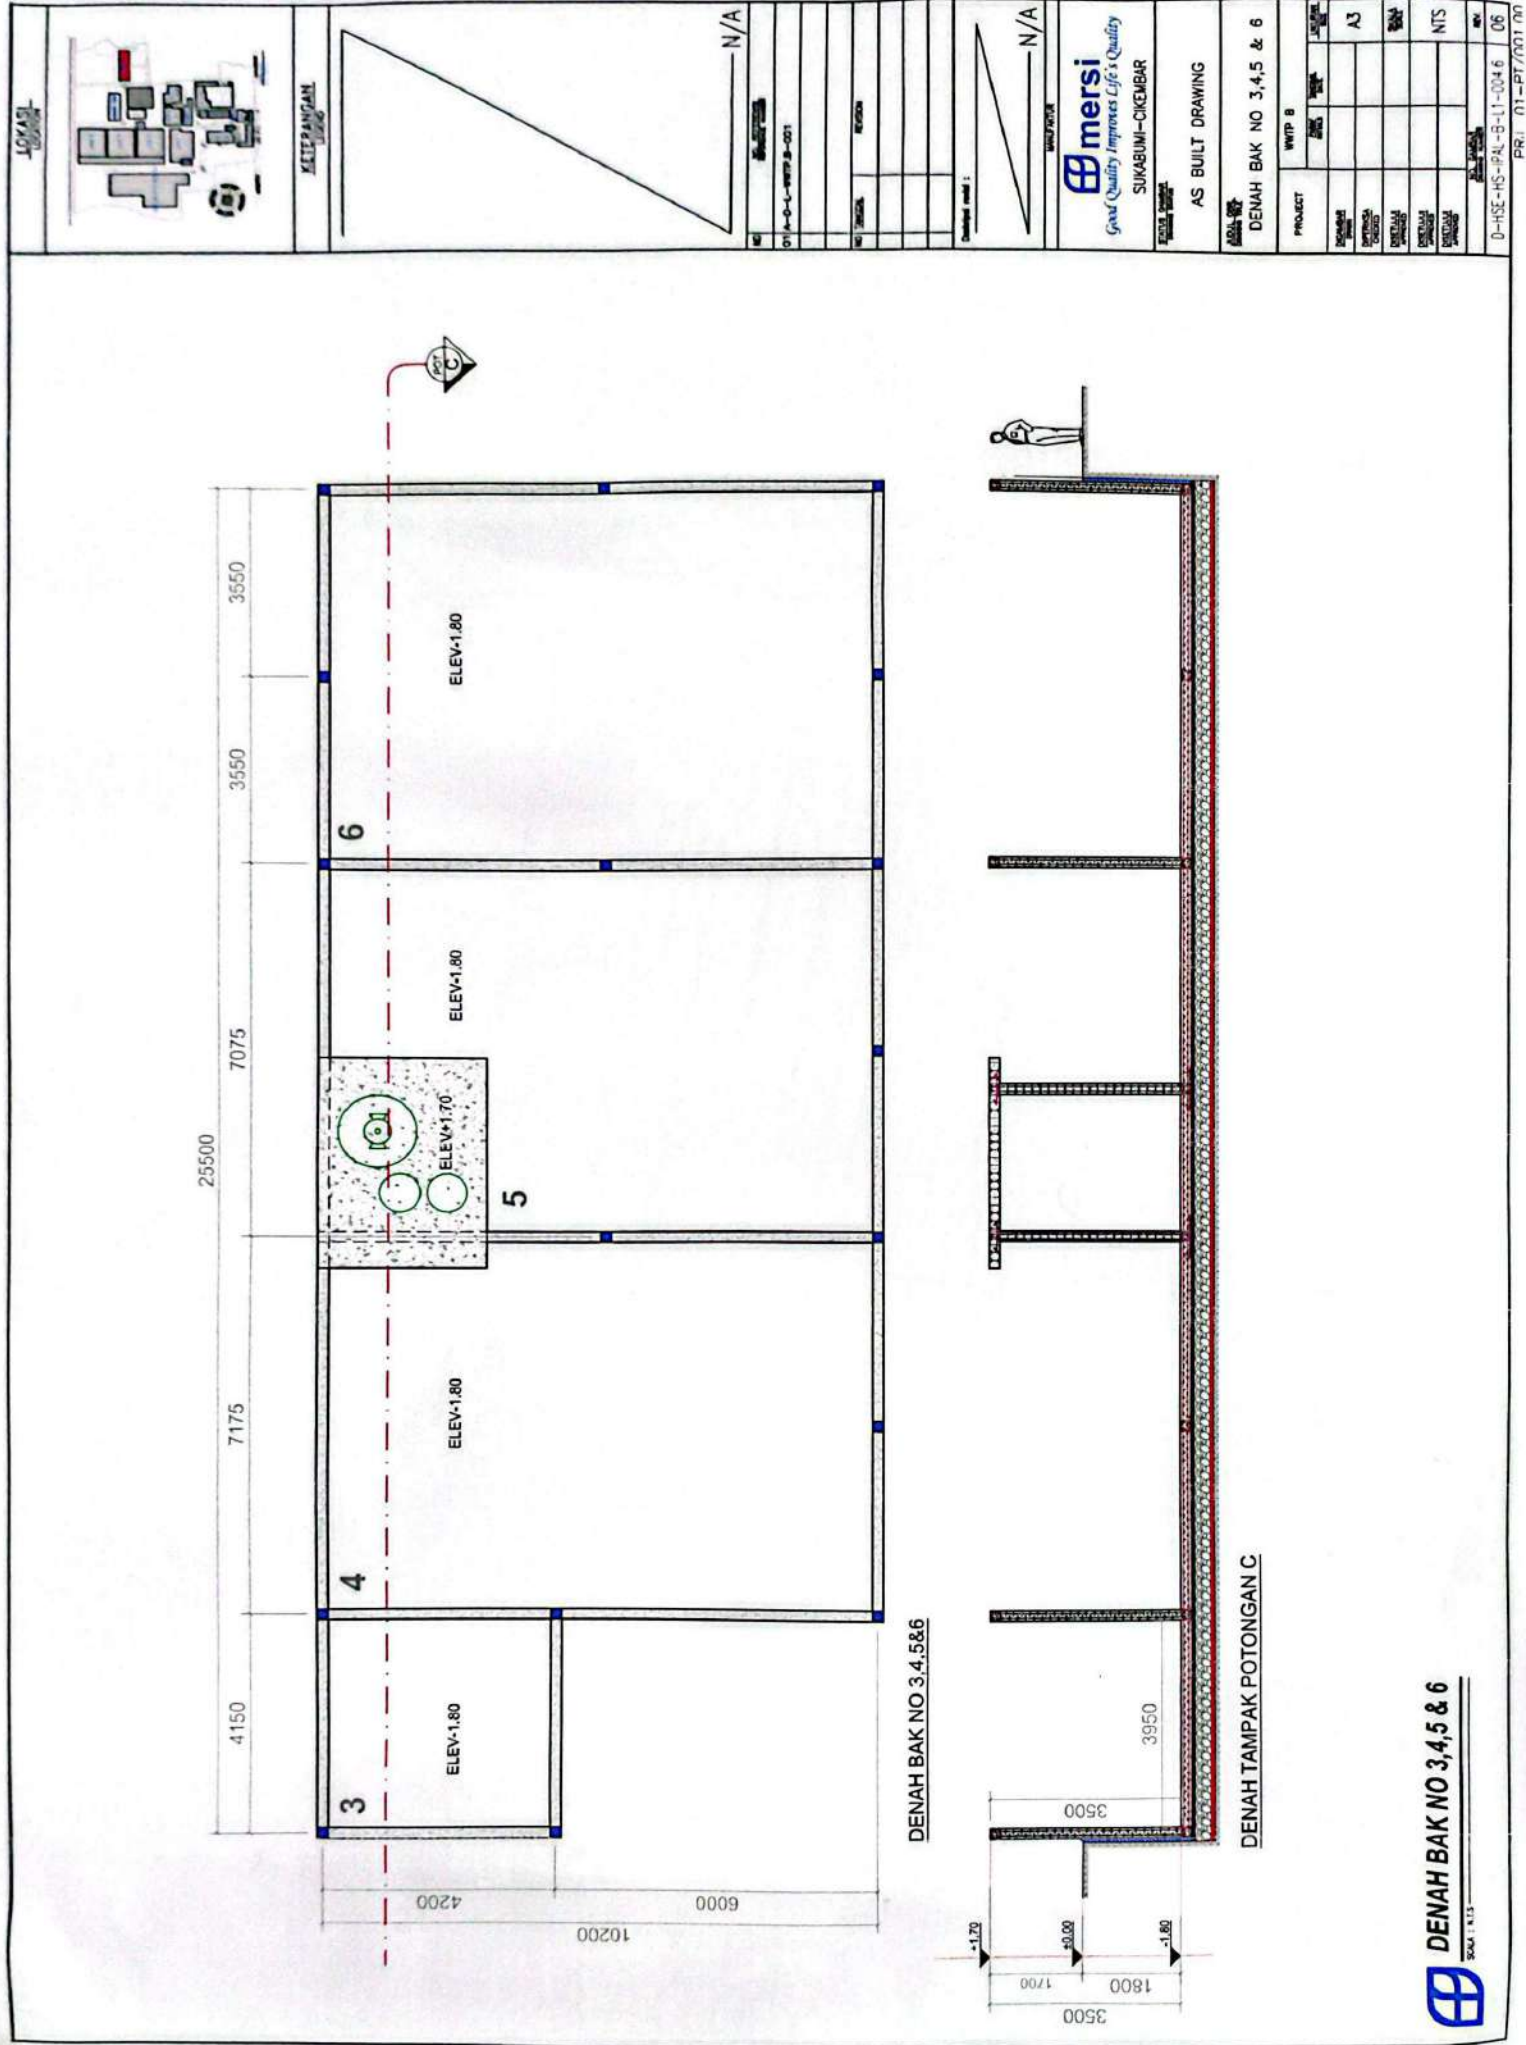

DENAH BAK NO 3,4,5&6

DENAH TAMPAK POTONGAN C

DENAH BAK NO 3,4,5 & 6



LOKASI

KETERANGAN

Dimensi (mm) : N/A

Dimensi (mm) : N/A

Dimensi (mm) : N/A

Dimensi (mm) : N/A

PT. MERSI

Good Quality Improves Life's Quality

SUKABUMI-CIKEMBAR

AS BUILT DRAWING

DENAH BAK NO 3,4,5 & 6

PROJECT : WWTB B

REVISI : A3

REVISI : B4

REVISI : NTS

REVISI : N/A

0-HSE-HS-PAL-B-11-104.6

06

PRJ: 01-PT/001.00