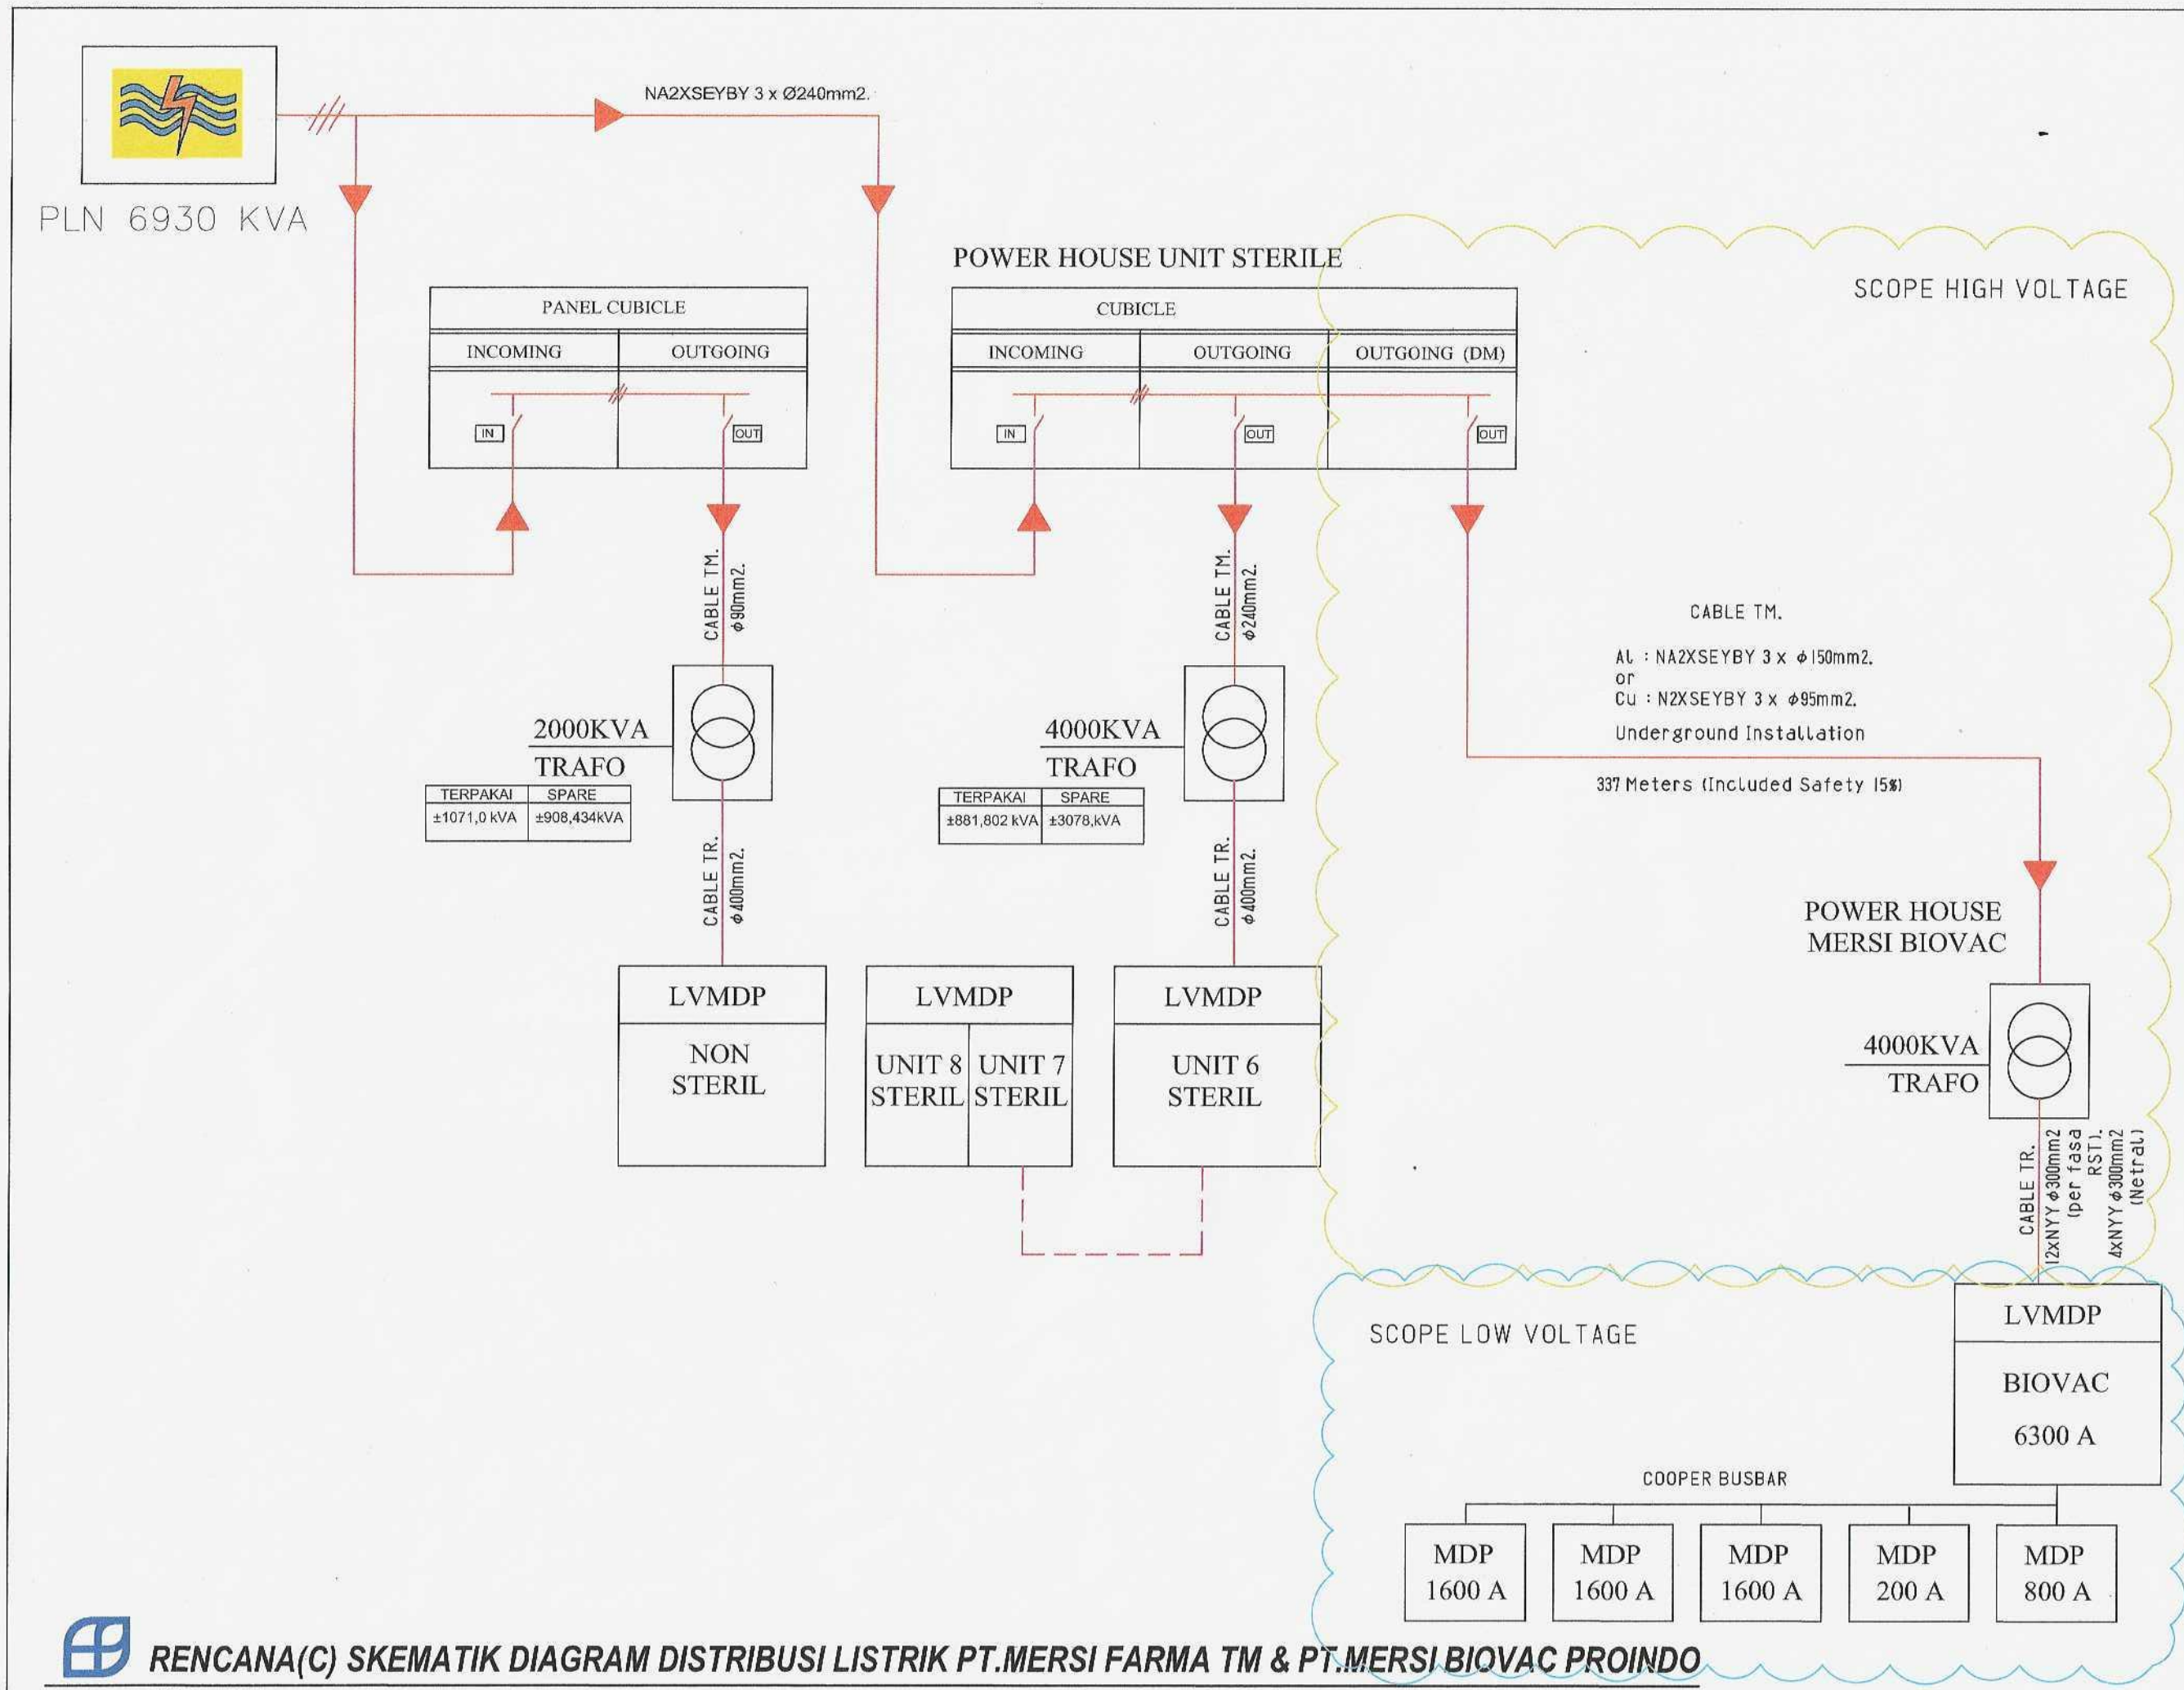

RENCANA(C) SKEMATIK DIAGRAM DISTRIBUSI LISTRIK PT.MERSI FARMA TM & PT.MERSI BIOVAC PROINDO

SKALA : N.T.S

SITE PLANT

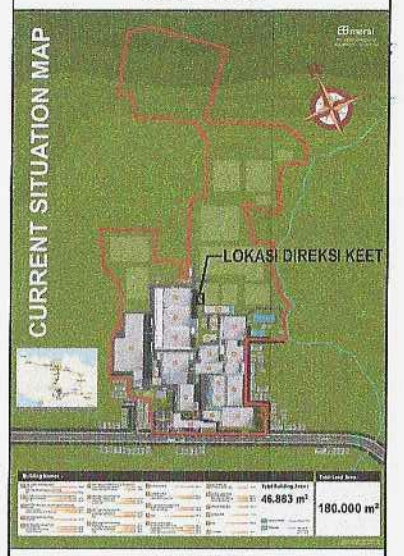

KETERANGAN

N/A

NO	NO. REFERENSI REFERENCE NUMBER

NO	TANGGAL	REVISION

Deskripsi revisi :

N/A

MANUFAKTUR

PT. MERSI BIOVAC PROINDO

STATUS GAMBAR DRAWING STATUS: SHOP DRAWING

JUDUL GBR. DRAWING TITLE: SKEMATIK DIAGRAM DISTRIBUSI LISTRIK PT.MERSI FARMA TM PT.MERSI BIOVAC PROINDO

PROJECT	LISTRIK		
	PARAF INITIALS	TANGGAL DATE	UKURAN SIZE
DIGAMBAR DRAWN		27/08 2026	A3
DIPERIKSA CHECKED		27/08 26.	
DISETUJUI APPROVED		27/08 26.	SKALA SCALE
DISETUJUI APPROVED		27/08 26	N.T.S
DISETUJUI APPROVED			

NO. GAMBAR DRAWING NUMBER	REV.
D-M-MBP.L1-03	02

PRJ. 01-PT/001.00

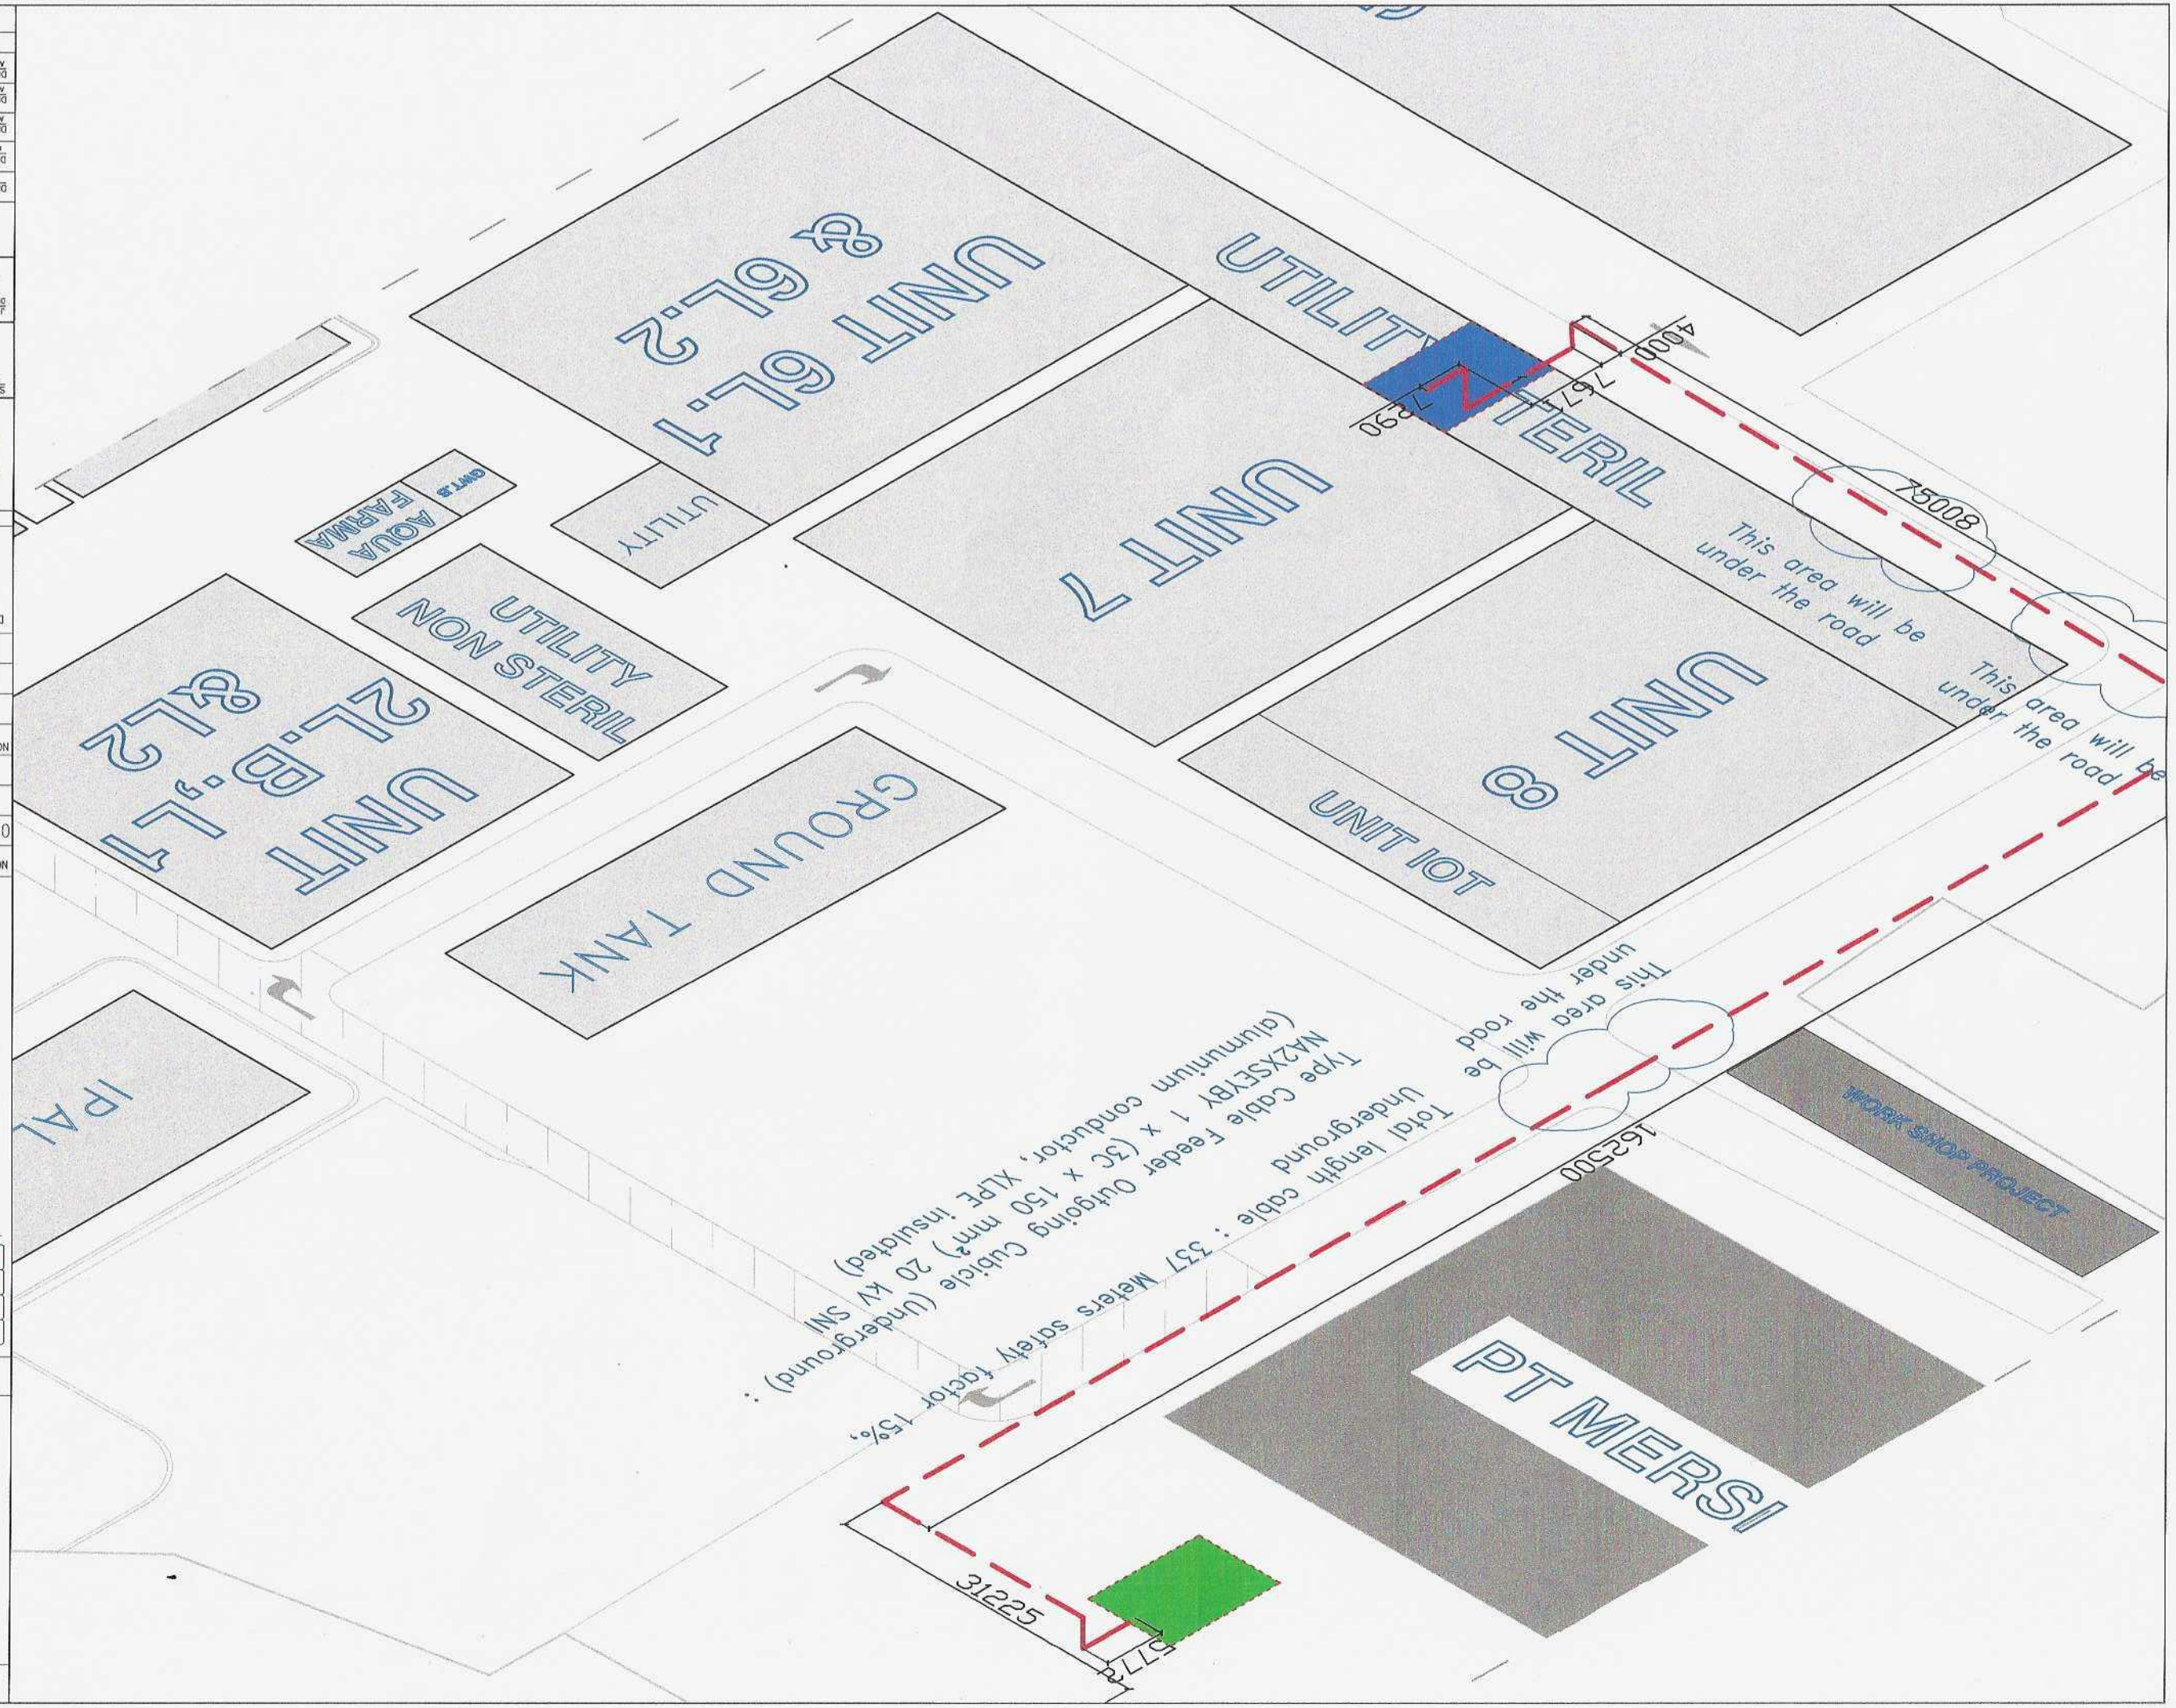

WIND DIRECTION
ARAH MATA ANGIN

N/A

KETERANGAN
LEGEND

SYMBOL	INFORMATION
	CABLE
	TRAFO & LVMDV (MERSIFARMA TM)
	TRAFO & LVMDV (BIOVAC)

N/A

NO	NO. REFERENSI / REFERENCE NUMBER
01	D-L-MF-L1.0001/SITE PLANT PT.MERSIFARMA TM

NO	TANGGAL	REVISION

Deskripsi revisi :

N/A

MANUFACTUR

PT. MERSI BIOVAC PROINDO

STATUS GAMBAR / DRAWING STATUS

AS BUILT DRAWING

JUDUL GBR / DRAWING TITLE

LAYOUT LINE DISTRIBUSI LISTRIK

PROJECT	PT.MERSI BIOVAC PROINDO		
	PARAF / INITIALS	TANGGAL / DATE	UK.GRAM / SIZE
DIGAMBAR / DRAWN		27/08/26	A3
DIPERIKSA / CHECKED		27/08/26	
DISETUJUI / APPROVED		27/08/26	SKALA / SCALE
DISETUJUI / APPROVED		27/08/26	NTS
DISETUJUI / APPROVED			

NO. GAMBAR / DRAWING NUMBER	REV.
PRJ. 01-PT/001.00	00